IREDELL COUNTY HEALTH DEPARTMENT

STATESVILLE 704-878-5305 MOORESVILLE 704-664-5281

IMPROVEMENT PERMIT / AUTHORIZATION TO CONSTRUCT / OPERATION PERMIT / EXISTING SYSTEM INSPECTION

PERMIT# 83646 PIN# 4765 72 1456 DATE 9-3-99

OWNER OR CONTRACTOR Kenny Burr PHONE: Business Home 877 0786

ADDRESS 136 Floyd LN Statesville, N.C.

LOCATION 64E TR Floyd Ln at end

SUBDIVISION BLOCK / SECTION LOT LOT AREA 2.08 acres SITE CLASS. P5 DESIGN FLOW L.T.A.R.

Septic Tank: 1500 Gallons; STB Date
Pump Tank: Gallons; PT Date
Pump Make: Model Serial No.
Nitrification Field: No Fields 1 Square Feet 1750 Linear Feet 300
No Lines 4 Trench Width 10' Max Trench Bottom Depth 36" Gravel Depth 10"

☐ New System ☐ Repair System Type: I, II, III, IV, V, VI
System Description:
Repair System Description:
Maintenance Agreement Required: ☐ Yes ☐ No


☐ House/Mod. Home No. Bedrooms 3
☐ Mobile Home No. Bathrooms 2
☐ Business No. Employees
☐ Other
☐ Slab ☐ Crawl Space ☐ Basement w/plumbing ☐ Basement wo/plumbing

Water Supply: ☐ Individual ☐ Public ☐ Community


Comments/Conditions:

Comments/Conditions System Installed 8-8-75 under William Edwards For 5 Bedroom Home

INITIAL SITE SKETCH

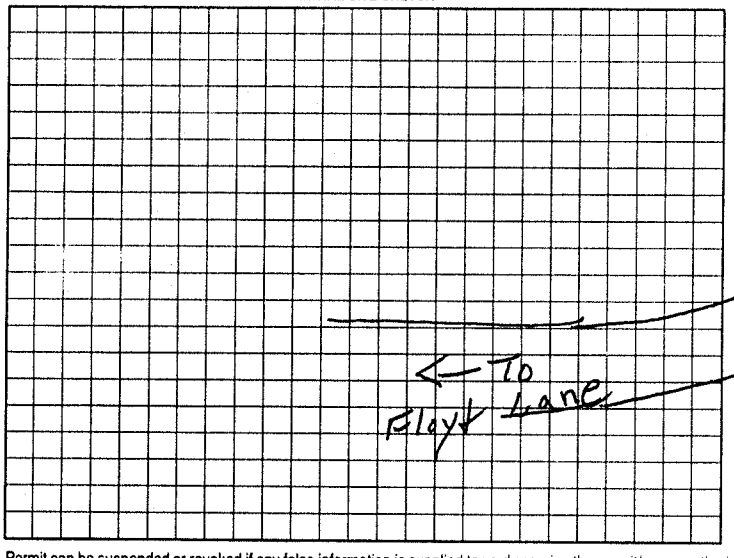

AS BUILT SKETCH

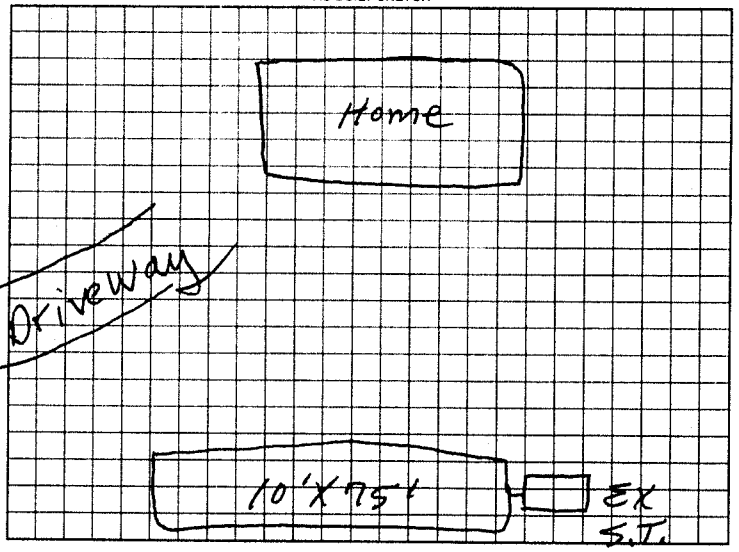

Permit can be suspended or revoked if any false information is supplied toward securing the permit/any unauthorized changes are made to the site/any unauthorized changes are made in the installation of the system. Improvement Permit with plat valid without expiration. Improvement Permit with site plan valid for sixty months. Authorization to Construct is valid for a period equal to that of Improvement Permit – not to exceed sixty months.

Signed: date

Improvement Permit by: date

Authorization to Construct by: date

Installed by: Sigmon

Operation Permit by: Andrew Carney date 8-8-75

Existing System Inspection by: E. C. Moore date 9-3-99

HEALTH DEPT. COPY: WHITE OWNER COPY (FINAL): YELLOW OWNER COPY (INITIAL): PINK