IREDELL COUNTY HEALTH DEPARTMENT

STATESVILLE 704-878-5305 MOORESVILLE 704-664-5281

IMPROVEMENT PERMIT / CERTIFICATE OF COMPLETION / OPERATION PERMIT / EXISTING SYSTEM INSPECTION

PROPERTY DESCRIPTION NO. REPAIR DATE 9/8/93 TAX MAP NO. 55-15-A-55

OWNER OR CONTRACTOR DAVID MILLSAPS PHONE: Business 873-1331 Home SAME

ADDRESS

LOCATION US 64 E, JR FLOYD DR, TL DINER LN, SYSTEM BETWEEN 3RD & 4TH MH'S ON (L)

SUBDIVISION VALLEY STREAM BLOCK / SECTION LOT 15/16 LOT AREA UNITED SITE CLASS. PS L.T.A.R. EXISTING

Water Supply: ☐ Individual ☐ Community ☑ Public

Septic Tank: EXISTING Gallons; STB Date

Pump Tank: Gallons; PT Date

Nitrification Field: No Fields 1 Square Feet Linear Feet 95'

No BED 1 Trench Width 6' Trench Depth 24-36" Gravel Depth 18"

☐ New System ☑ Repair System Type: I (II) III IV V VI

System Description: CONV GRAVITY

Repair System Description:

Maintenance Agreement Required: ☐ Yes ☑ No

☐ House/Mod. Home ☑ Mobile Home x 2 ☐ Business ☐ Other

No. Bedrooms No. Bathrooms No. Employees

☐ Slab ☑ Crawl Space ☐ Basement w/plumbing ☐ Basement wo/plumbing

Garbage Disposal: ☐ Yes ☐ No


Auto. Dishwasher: ☐ Yes ☐ No

Auto. Washing Machine: ☐ Yes ☐ No

Other

Comments (1) CHECK SEPTIC TANK FOR INTEGRITY, PUMP-OUT & REPLACE SANITARY TEE IF NECESSARY. (2) INTERSECT EXISTING LINE AT LOCATION SHOWN AND STEPDOWN TO NEW 6'x95' BED. (3) INSTALL BED ON CONTOUR, NO DEEPER THAN 36", USING 18" STONE.

INITIAL SITE SKETCH

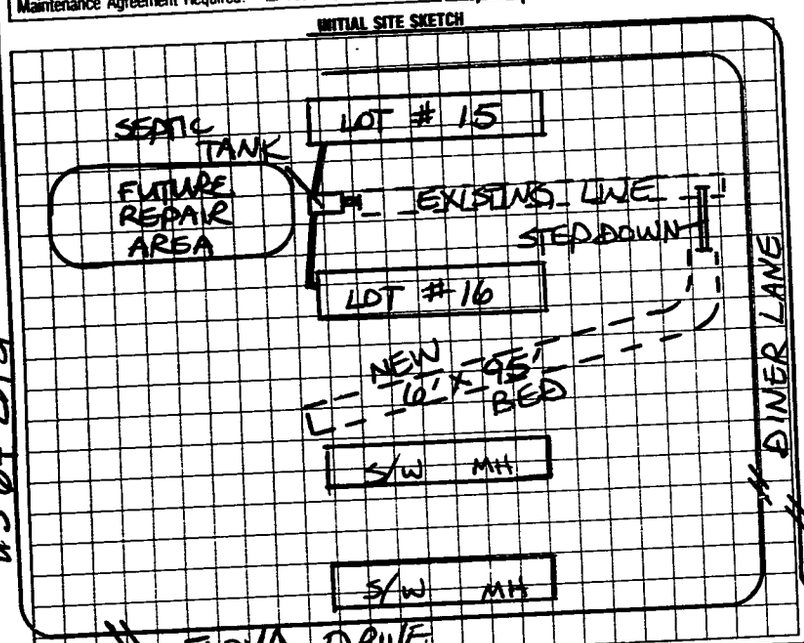

AS BUILT SKETCH

REPAIRED ACCORDING TO INITIAL SITE SKETCH.

I understand that this permit can be suspended or revoked if any false information is supplied toward securing the permit/any unauthorized changes are made to the site/any unauthorized changes are made in the installation of the system. Improvement Permit is valid for 60 months from date of issuance.

Signed: x David Millsaps date 9/8/93 Installed by: DONALD LACKEY

Improvement Permit by: STEVE HEDRICK date 9/8/93 Certificate of Completion by: STEVE HEDRICK date 10/5/93

Existing System Inspection by: date Operation Permit by: date

HEALTH DEPT. COPY: WHITE INSPECTION COPY (FINAL): GREEN OWNER COPY (FINAL): YELLOW INSPECTION COPY (INITIAL): PINK OWNER COPY (INITIAL): GOLD