IREDELL COUNTY HEALTH DEPARTMENT

Statesville Phone TR 3-7271 Mooresville Phone NO 3-1271

PERMIT TO INSTALL SEPTIC TANK

Permit NO. Smith Texaco sta, Permit Date Dec 3 1964

Owner JT Alexander Address Hwy 64 E.

Installed By C Hoke Address R 7


Location of Property Texaco Sta on left past Beaver Store

Tank		Capacity		Length of Lines		Fixtures	
Block	( )	800	( )	150'	( )	No. of Baths	( )
Precast	(✓)	900	( )	175'	( )	Dishwasher	( )
		1000	(✓)	200'	( )	Garbage Grdr.	( )
		1100	( )	225'	(✓)	Auto-Washer	( )
		1200	( )	250'	( )	Other Station 2 Stools	
		Other		Other			

NOTIFY HEALTH DEPARTMENT AT LEAST EIGHT HOURS BEFORE TANK IS TO BE INSPECTED.

Final Inspection 12-3 1964 Approved (✓) Disapproved ( )

Remarks no well this date

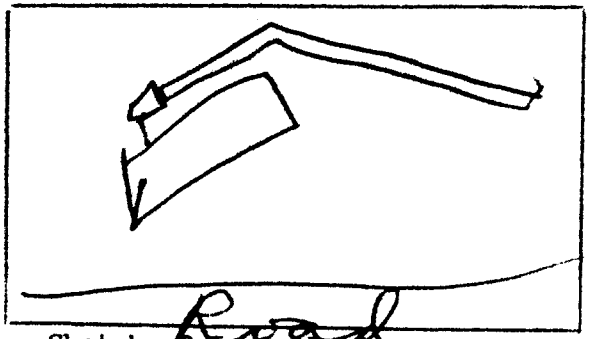

Sketch of Installation

RL.

Sanitarian