IREDELL COUNTY HEALTH DEPARTMENT - *ENVIRONMENTAL HEALTH* ☐ STATESVILLE OFFICE 704-878-5305 ☐ MOORESVILLE OFFICE 704-664-5281

IMPROVEMENT PERMIT / AUTHORIZATION TO CONSTRUCT / OPERATION PERMIT / EXISTING SYSTEM INSPECTION

PERMIT # Repair PIN # 4765-73-7264 DATE 18 March 2011

OWNER Charles Wall APPLICANT: PHONE: Home/Cell # Business # (704) 872-4064

SITE ADDRESS 808 Mocksville Hwy Statesville OWNER / APPLICANT ADDRESS

SITE DIRECTIONS Mocksville Hwy 1 mile ± on Rt. past Fuquay


SUBDIVISION BLOCK / SECTION LOT # LOT AREA 1.3 ac. DESIGN FLOW 360 gpd L.T.A.R. 0.3 gpd/ft²

Septic Tank 1000	Gallons: STB 794	Date 4-3-11	☐ New System ☑ Repair ☐ Expansion System Type I II (III) IV V VI	☑ Residence	No. Bedrooms 3	Water Supply
Pump Tank	Gallons: P T	Date	System Description:	☐ Business	No. Persons	☑ Private
Pump Make	Model	Serial #	Repair System Description: 25% Reduction system	☐ Other	No. Employees	☐ Public
No. Nitrification Fields: 1	No. Lines 4	Linear Feet 300	Maintenance Agreement Required ☐ YES ☑ NO	☐ Slab	☐ Crawl Space	☐ Community
Trench Width 36"	Max. Trench Bottom Depth 36"	Gravel Depth NA	☑ GRAVITY ☐ PRESSURE	☐ Basement w/plumbing	☑ Basement w/o plumbing	


Comments / Conditions * Replumb under house and move Septic Tank location to the front. Follow contours / Keep 50' from N / well

Poly lock Filter - ST has mark -

INITIAL SITE SKETCH

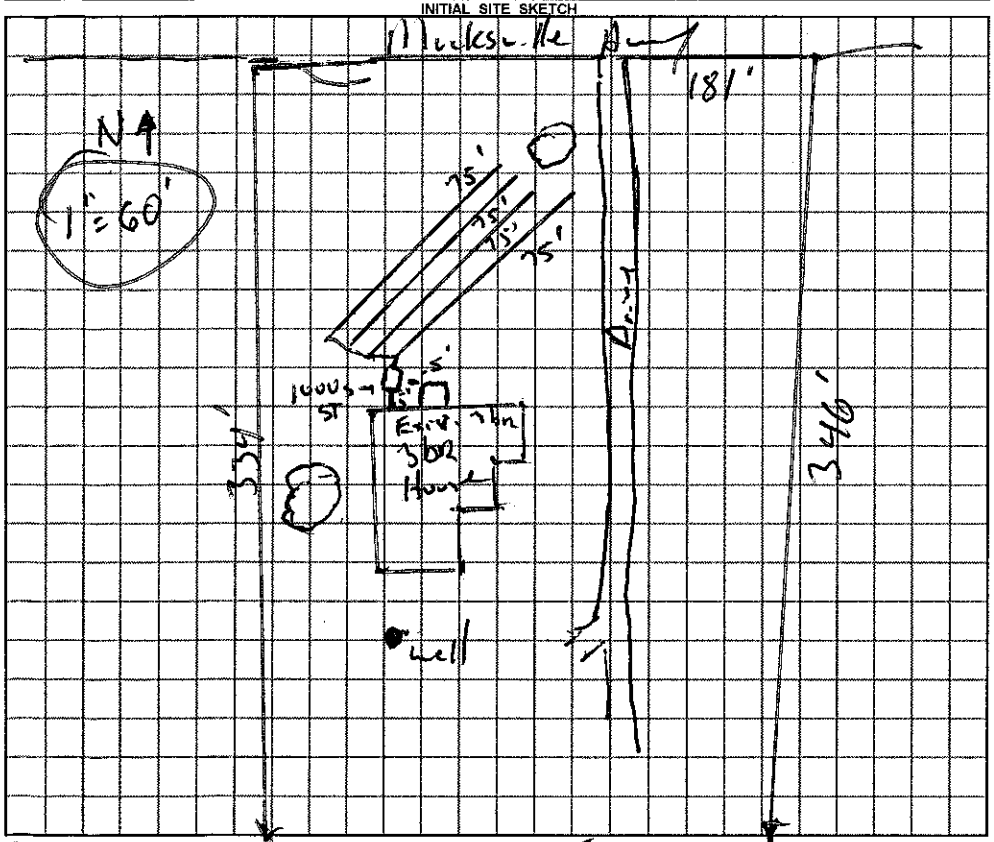

AS BUILT SKETCH

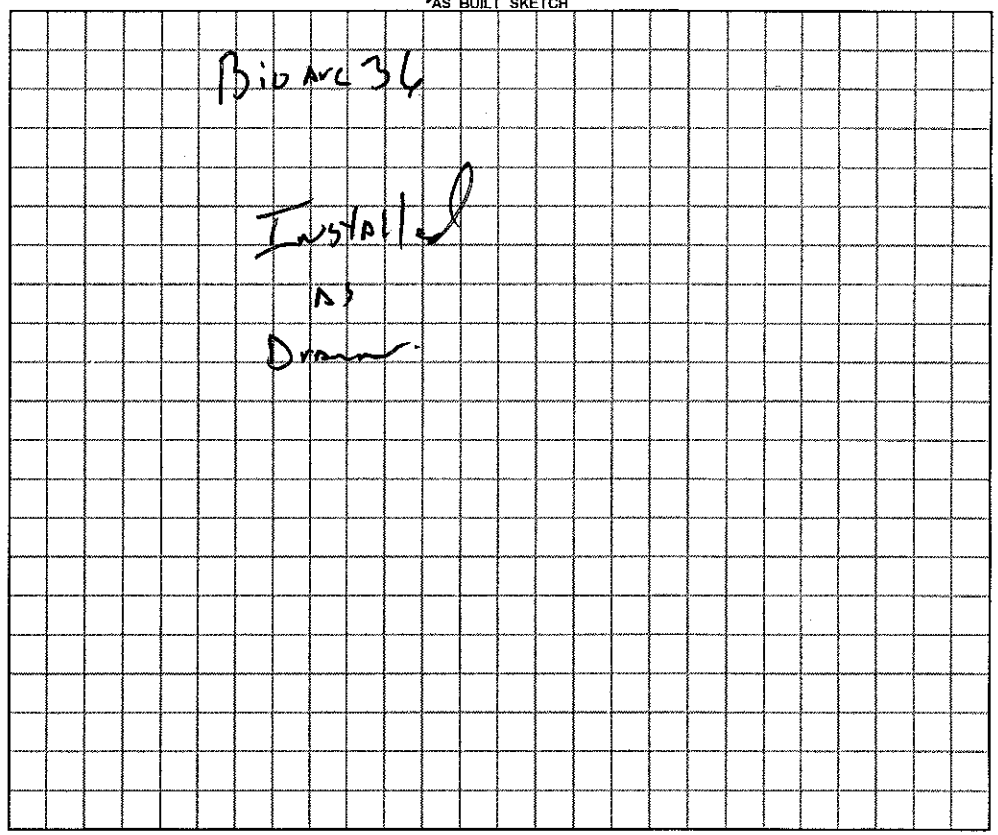

Permit can be suspended or revoked if any false information is supplied toward securing the permit / any unauthorized changes are made to the site / any unauthorized changes are made in the installation of the system.

☐ ***IMPROVEMENT PERMIT*** with plat valid without expiration. ☑ ***IMPROVEMENT PERMIT*** ~~with plat valid without expiration.~~ site plan valid 60 mo. ☑ ***AUTHORIZATION TO CONSTRUCT*** valid for period equal to IMPROVEMENT PERMIT--not to exceed 60 mo.

Owner / Applicant Signature: Charles Wall Date 4-11-11 Installed by: James Huddler

IMPROVEMENT PERMIT by: REHS Date 18 March 11 OPERATION PERMIT by: REHS Date 12 May 11

AUTHORIZATION TO CONSTRUCT by: REHS Date 18 March 11 Existing System Inspected by: REHS Date

YOU SHOULD CONTACT A LOCATOR SERVICE PRIOR TO ANY EXCAVATION

White Copy – Environmental Health YELLOW COPY (Final) Owner / Applicant PINK COPY (Initial) Owner / Applicant