IREDELL COUNTY HEALTH DEPARTMENT

Statesville Phone TR 3-7271 Mooresville Phone NO 3-1271

PERMIT TO INSTALL SEPTIC TANK

Permit No. 231 Permit Date _____ 19__

Owner Ray Warren Address Statesville

Installed By Floyd Adams Address Taylorsville


Location of Property Hgwy 64 E to Jimmies Upholstering Service. House in woods behind buildings.

Tank		Capacity		Length of Lines		Fixtures	
Block	( )	1000	( )	225'	( )	No. of Baths	(4)
Precast	(✓)	1250	( )	250'	( )	Dishwasher	( )
		1500	( )	Other 240'		Garbage Grdr.	( )
		Other _____				Other _____	

NOTIFY HEALTH DEPARTMENT AT LEAST EIGHT HOURS BEFORE TANK IS TO BE INSPECTED.

Final Inspection 4-23-71 Approved (✓) Disapproved ( )

Remarks Washer line seperate

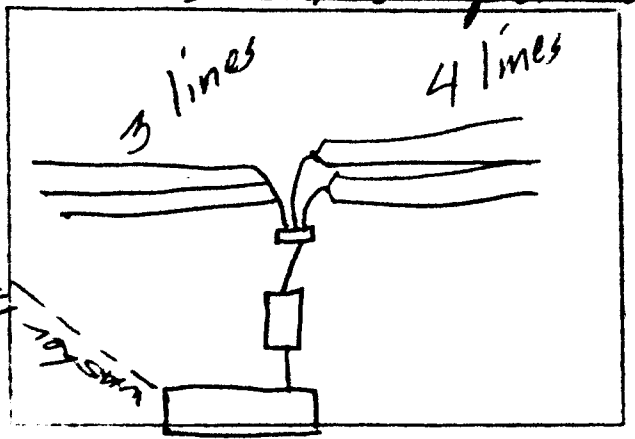

Sketch of Installation

Leon S. Hall

Sanitarian