IREDELL COUNTY HEALTH DEPARTMENT

STATESVILLE 704-878-5305 (ar) MOORESVILLE 704-664-5281

IMPROVEMENT PERMIT / AUTHORIZATION TO CONSTRUCT / OPERATION PERMIT / EXISTING SYSTEM INSPECTION

PERMIT # 157881 PIN # 4765-74-4181 DATE 8-20-09

OWNER or APPLICANT (RW Wright Const.) Tommy & Joan Smith PHONE: Business 704 902 1443 Home: 704 876 6906

OWNER or APPLICANT ADDRESS 164 Foxglove Dr. / Statesville, NC

LOCATION / DIRECTIONS 125 Leyland Dr.

SUBDIVISION n/a BLOCK / SECTION n/a LOT # n/a LOT AREA .883 DESIGN FLOW 240 L.T.A.R. .25

Septic Tank 1000 Gallons: STB 1012 Date 6-29-09

Pump Tank ____ Gallons: PT ____ Date ____

Pump Make ____ Model ____ Serial # ____

Nitrification Field No Fields 1 No Lines 3 Linear Feet 240

Trench Width 36" Max. Trench Bottom Depth 36" Gravel Depth n/a

☒ New System ☐ Repair ☐ Expansion System Type I II III IV V VI

System Description: Gravity 25% Reduction

Repair System Description: Pump 25% Reduction

Maintenance Agreement Required ☐ YES ☒ NO

☒ GRAVITY ☐ PRESSURE

☒ Residence No. Bedrooms 2

☐ Business No. Persons ____

☐ Other No. Employees ____

☐ Slab ☒ Crawl Space


☐ Basement w/plumbing ☐ Basement w/o plumbing

Water Supply: ☐ Private ☒ Public ☐ Community


Comments / Conditions: Place down terrace.

Comments / Conditions

INITIAL SITE SKETCH

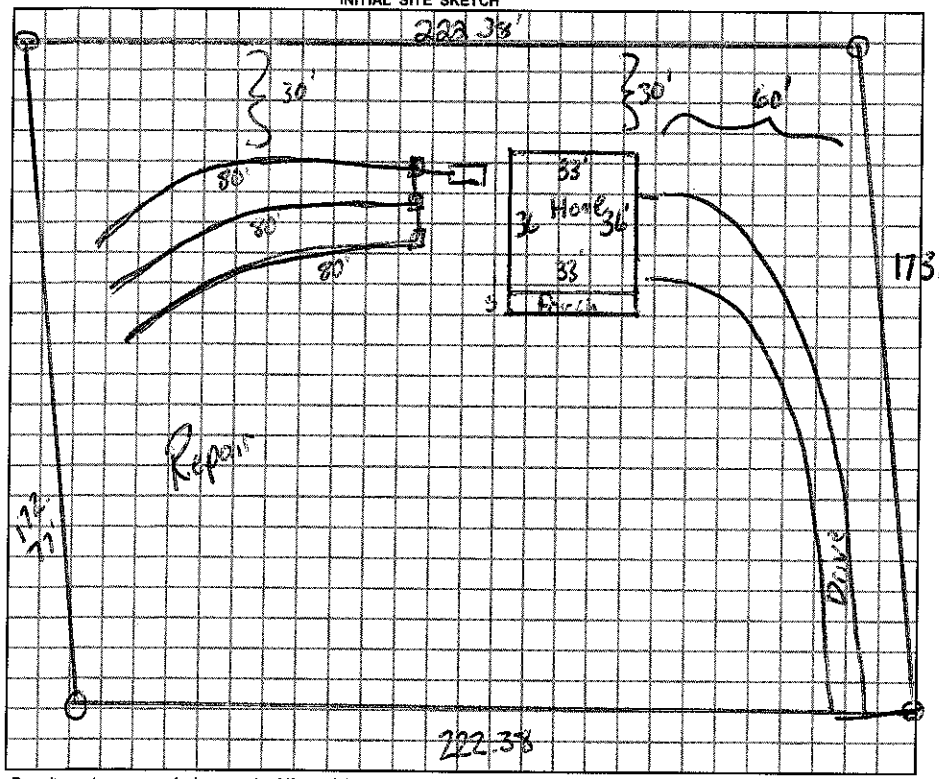

AS BUILT SKETCH

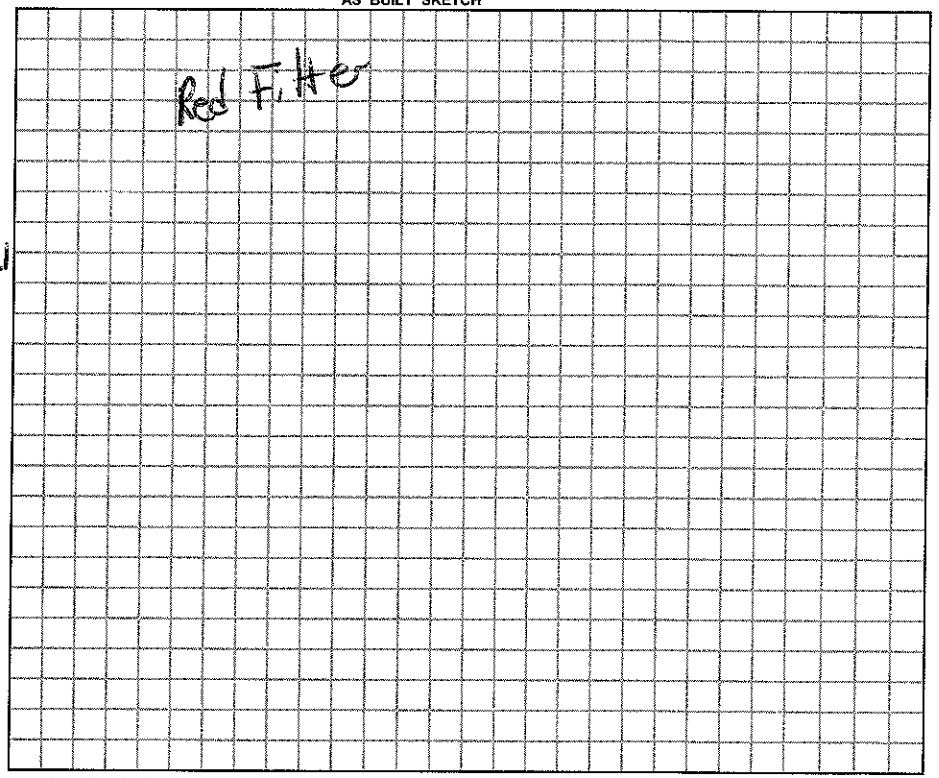

Permit can be suspended or revoked if any false information is supplied toward securing the permit / any unauthorized changes are made to the site / any unauthorized changes are made in the installation of the system.

☐ *IMPROVEMENT PERMIT w / plat valid without expiration.* ☒ *IMPROVEMENT PERMIT w / site plan valid for 60 mos.* ☒ *AUTHORIZATION TO CONSTRUCT valid for period equal to IMPROVEMENT PERMIT-not to exceed 60 mo.*

Owner / Applicant Signature: Rob Wright Date 8-21-09

Improvement Permit by: [signature] Date 8-20-09

Authorization to Construct by: [signature] Date 8-20-09

Installed by: Tommy Fry

Operation Permit by: [signature] Date: 9-9-9

Existing System Inspected by: ____ Date: ____

YOU SHOULD CONTACT A LOCATOR SERVICE PRIOR TO ANY EXCAVATION.

WHITE COPY Environmental Health YELLOW COPY (Final) Owner / Applicant PINK COPY (Initial) Owner / Applicant