IREDELL COUNTY HEALTH DEPARTMENT

STATESVILLE 704-878-5305 MOORESVILLE 704-664-5281

IMPROVEMENT PERMIT / AUTHORIZATION TO CONSTRUCT / OPERATION PERMIT / EXISTING SYSTEM INSPECTION

PERMIT# 95251+83854 PIN# 4765 74 9066 DATE 8-8-98

OWNER OR CONTRACTOR Grace Alliance Fellowship PHONE: Business 872 0038 Home

ADDRESS 1048 W Front St. Statesville N.C.

LOCATION 64E 1/2 mi Past Bell Em Rd on left.

SUBDIVISION BLOCK / SECTION LOT LOT AREA 6 acres SITE CLASS. PS DESIGN FLOW 1500 GPD L.T.A.R. .4 gal/sq ft/day

Septic Tank: 3000 Gallons; STB 7 Date 11-23-99

Pump Tank: 3000 Gallons; PT 7 Date 9-8-99

Pump Make: Model Serial No.

Nitrification Field: No Fields 1 Square Feet 3750 Linear Feet 1250

No Lines 12 Trench Width 36" Max Trench Bottom Depth 36" Gravel Depth 12"

☒ New System ☐ Repair System Type: I II III IV V VI

System Description: Pump To Conv. Lines

Repair System Description: " " 25% Red.

Maintenance Agreement Required: ☐ Yes ☒ No

☐ House/Mod. Home No. Bedrooms

☐ Mobile Home No. Bathrooms

☐ Business No. Employees

☒ Other Church 300 Seats

☐ Slab ☒ Crawl Space ☐ Basement w/plumbing ☐ Basement wo/plumbing


Water Supply: ☐ Individual ☒ Public ☐ Community

Comments/Conditions:


See Attachet Sheets for Pump Tanks & manifold Setup. They are part of This Permit.

Comments/Conditions: Inspected Drain Lines S.T. P.T. Did leakage Test on PT Pressure manifold 11-24-99 JCM

INITIAL SITE SKETCH

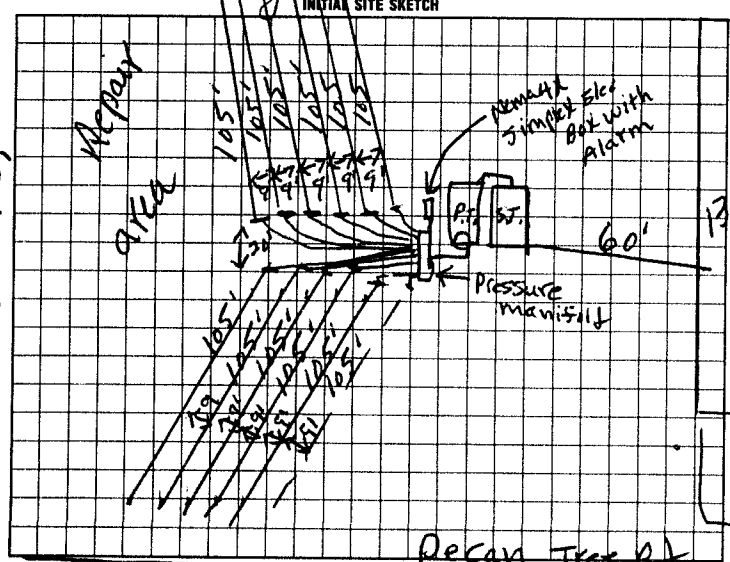

AS BUILT SKETCH

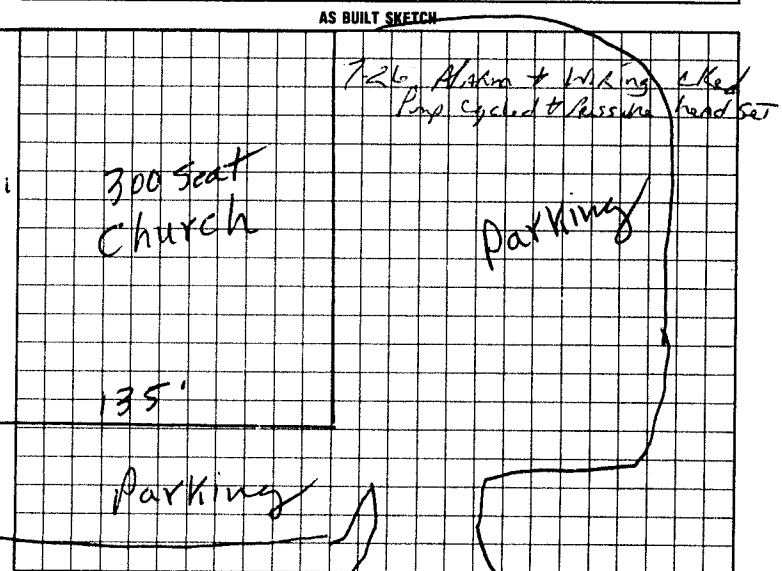

US 64E

I understand that this permit can be suspended or revoked if any false information is supplied toward securing the permit/any unauthorized changes ~~are made~~ to the site/any unauthorized changes are made in the installation of the system. Improvement Permit with plat valid without expiration. Improvement Permit with site plan valid for sixty months. Authorization to Construct is valid for a period equal to that of Improvement Permit – not to exceed sixty months.

Signed: Ted Symonson date 10-9-98

Improvement Permit by: P.C. Moore date 8-8-98

Authorization to Construct by: P.C. Moore date 8-8-98

Installed by: James Huddle

Operation Permit by: JC Potter date July 26, 2000

Existing System Inspection by: date

HEALTH DEPT. COPY: WHITE INSPECTION COPY (FINAL) GREEN OWNER COPY (FINAL): YELLOW INSPECTION COPY (INITIAL): PINK OWNER COPY (INITIAL): GOLD