IREDELL COUNTY HEALTH DEPARTMENT

STATESVILLE 704-878-5305 MOORESVILLE 704-664-5281

IMPROVEMENT PERMIT / CERTIFICATE OF COMPLETION / OPERATION PERMIT / EXISTING SYSTEM INSPECTION

PROPERTY DESCRIPTION NO. 67440 DATE 6-26-97 TAX MAP NO. 4765 75 0709 Watershed: ☐ Yes ☒ No

OWNER OR CONTRACTOR Gary E. Ervin PHONE: Business _____ Home 704-873 7771

ADDRESS 427 Windsor Ln. Sta.

LOCATION 64E to Riverhill Rd TR Oakhaven at ent across on Shady Dr.

SUBDIVISION Countrywoods BLOCK / SECTION _____ LOT 52+53 LOT AREA 63,650 sf SITE CLASS. PS DESIGN FLOW 360 L.T.A.R. .33

Septic Tank: 1000 Gallons; STB 1012 Date _____

Pump Tank: _____ Gallons; PT _____ Date _____

Pump Make: _____ Model _____ Serial No. _____

Nitrification Field: No Fields 1 Square Feet 1080 Linear Feet 360

No Lines 3 Trench Width 36" Max Trench Bottom Depth 36" Gravel Depth 12"

☒ New System ☐ Repair System Type: I, ☐ II, III, IV, V, VI

System Description: Conv. Gravity

Repair System Description: Pump To Chambers

Maintenance Agreement Required: ☐ Yes ☐ No

☒ House/Mod. Home ☐ Mobile Home ☐ Business ☐ Other

No. Bedrooms 3 No. Bathrooms 2 No. Employees _____

☐ Slab ☒ Crawl Space ☐ Basement w/plumbing ☒ Basement wo/plumbing


Water Supply: ☐ Individual ☐ Community ☒ Public

Comments:


* No Basement - Tank is ~8 ft from corner of house lines ~15 ft from front corner 347.39'

Comments:

INITIAL SITE SKETCH

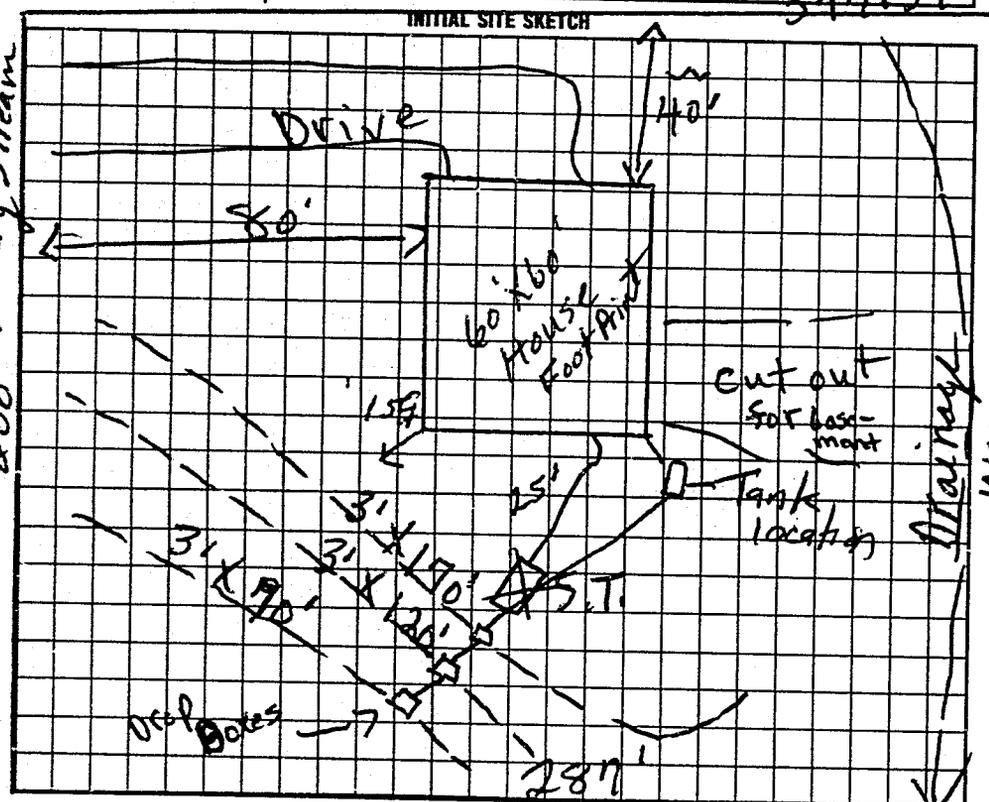

AS BUILT SKETCH

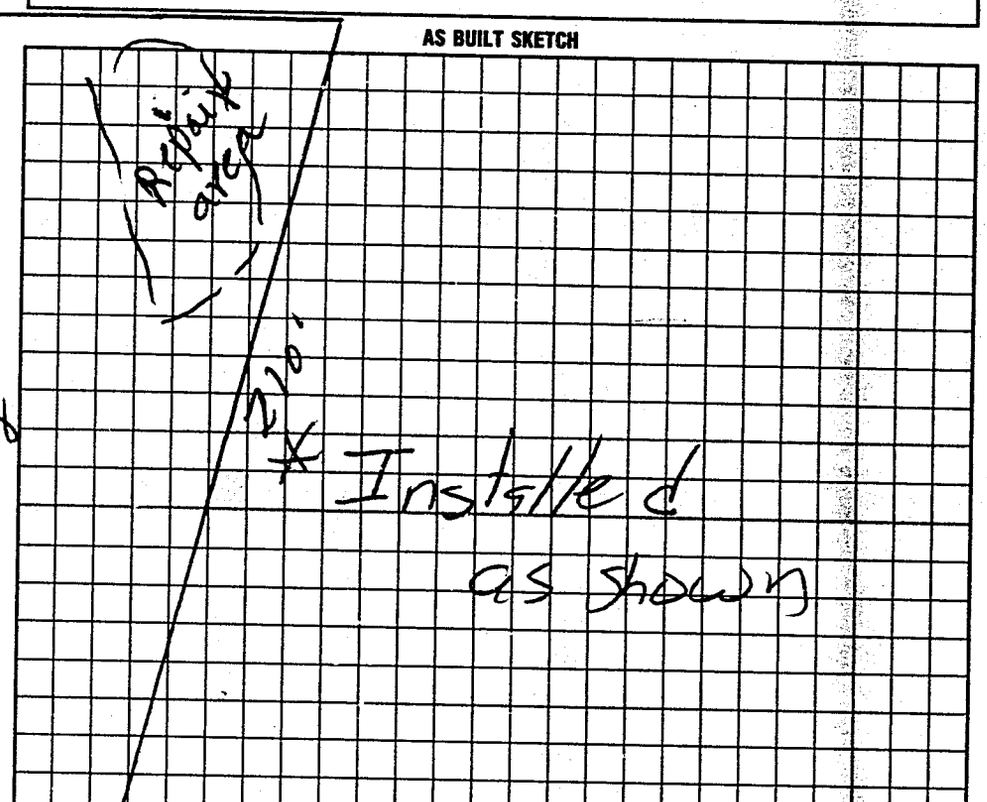

I understand that this permit can be suspended or revoked if any false information is supplied toward securing the permit/any unauthorized changes are made to the site/any unauthorized changes are made in the installation of the system. Improvement Permit is valid for 60 months from date of issuance,

Signed: X Gary E. Ervin

Improvement Permit by: P.C. Moore date 6-26-97

Authorization to Existing System Inspection by: P.C. Moore date 6-26-97

Installed by: Tommy Frye

Certificate of Completion by: _____ date _____

Operation Permit by: Mark C Oaks date 3-12-98

HEALTH DEPT. COPY: WHITE INSPECTION COPY (FINAL): GREEN OWNER COPY (FINAL): YELLOW INSPECTION COPY (INITIAL): PINK OWNER COPY (INITIAL): GOLD

to count. Authorization to count EXPIRES 60 MOS FROM ISSUE