IREDELL COUNTY HEALTH DEPARTMENT

Statesville Office (704) 878-5305 Mooresville Office (704) 660-3625 PERMIT # 21972

IMPROVEMENT PERMIT / AUTHORIZATION TO CONSTRUCT / OPERATION PERMIT / EXISTING SYSTEM

PIN # 4765801772

APPLICANT: BRUCE PORTER APPLICANT ADDRESS: 2143 MOCKSVILLE HWY STATESVILLE NC 28625

SITE ADDRESS: 138 LONEHART LN STATESVILLE NC 28625 PHONE: ALT. PHONE: 704 902 3124

SITE DIRECTIONS: 64 E - TR LONE PINE RD - TR LONEHART LN - ON RT NEAR END

SUBDIVISION: LONE PINE MEADOWS SECTION: 3 LOT # 12 LOT AREA: .474 AC DESIGN FLOW: 360 GPD L.T.A.R.: .3 gpd/ft²

Septic Tank 1000 (gal) STB 160 Date 7/21/15
Pump Tank (gal) PT Date
Pump Make Model Serial #
Nitrification Fields 1 # Lines 3 ~~Linear Ft:~~ 300
Trench Width 36" Max. Trench Bottom Depth 32" Gravel Depth N/A

☑ New System ☐ Repair ☐ Expansion System Type: I II (III) IV V VI
System Description: GRAVITY 25% REDUCTION
Repair System Description: LP PPBPS
Maintenance Agreement Required: ☐ YES ☑ NO
☑ GRAVITY ☐ PRESSURE

☑ Residence ☐ Business ☐ Other ☐ Slab ☑ Crawl Space ☐ Basement w/plumbing ☐ Basement w/o plumbing
No. Bedrooms 3 No. Persons 2 No. Employees
Water Supply: ☐ Private ☑ Public ☐ Community

Comments / Conditions:

INITIAL SITE SKETCH

SEE PENNINGER SOIL & DESIGN. CONSULTING, PLLC'S

AS BUILT SKETCH

Permit can be suspended or revoked if any false information is supplied toward securing the permit / any unauthorized changes are made to the site / any unauthorized changes are made in the installation of the system. **CONTACT A LOCATOR SERVICE PRIOR TO ANY EXCAVATION**


☐ **IMPROVEMENT PERMIT** *with plat valid without expiration.* ☑ **IMPROVEMENT PERMIT** *with site plan valid for 60 mos.* ☑ **AUTHORIZATION TO CONSTRUCT** *valid for period equal to IMPROVEMENT PERMIT--not to exceed 60 mo.*

Owner / Applicant Signature: Bruce Port Date: 6-29-16 Installed by: Cothern & Sons

IMPROVEMENT PERMIT by: [signature] Date: 6/28/16 OPERATION PERMIT by: Wesley Sparks Date: 10/5/16

AUTHORIZATION TO CONSTRUCT by: [signature] Date: 6/28/16 Existing System Inspected by: Date:

Health Dept. Copy - WHITE Applicant (Final Approval) - YELLOW Applicant (Conditional Approval) - PINK

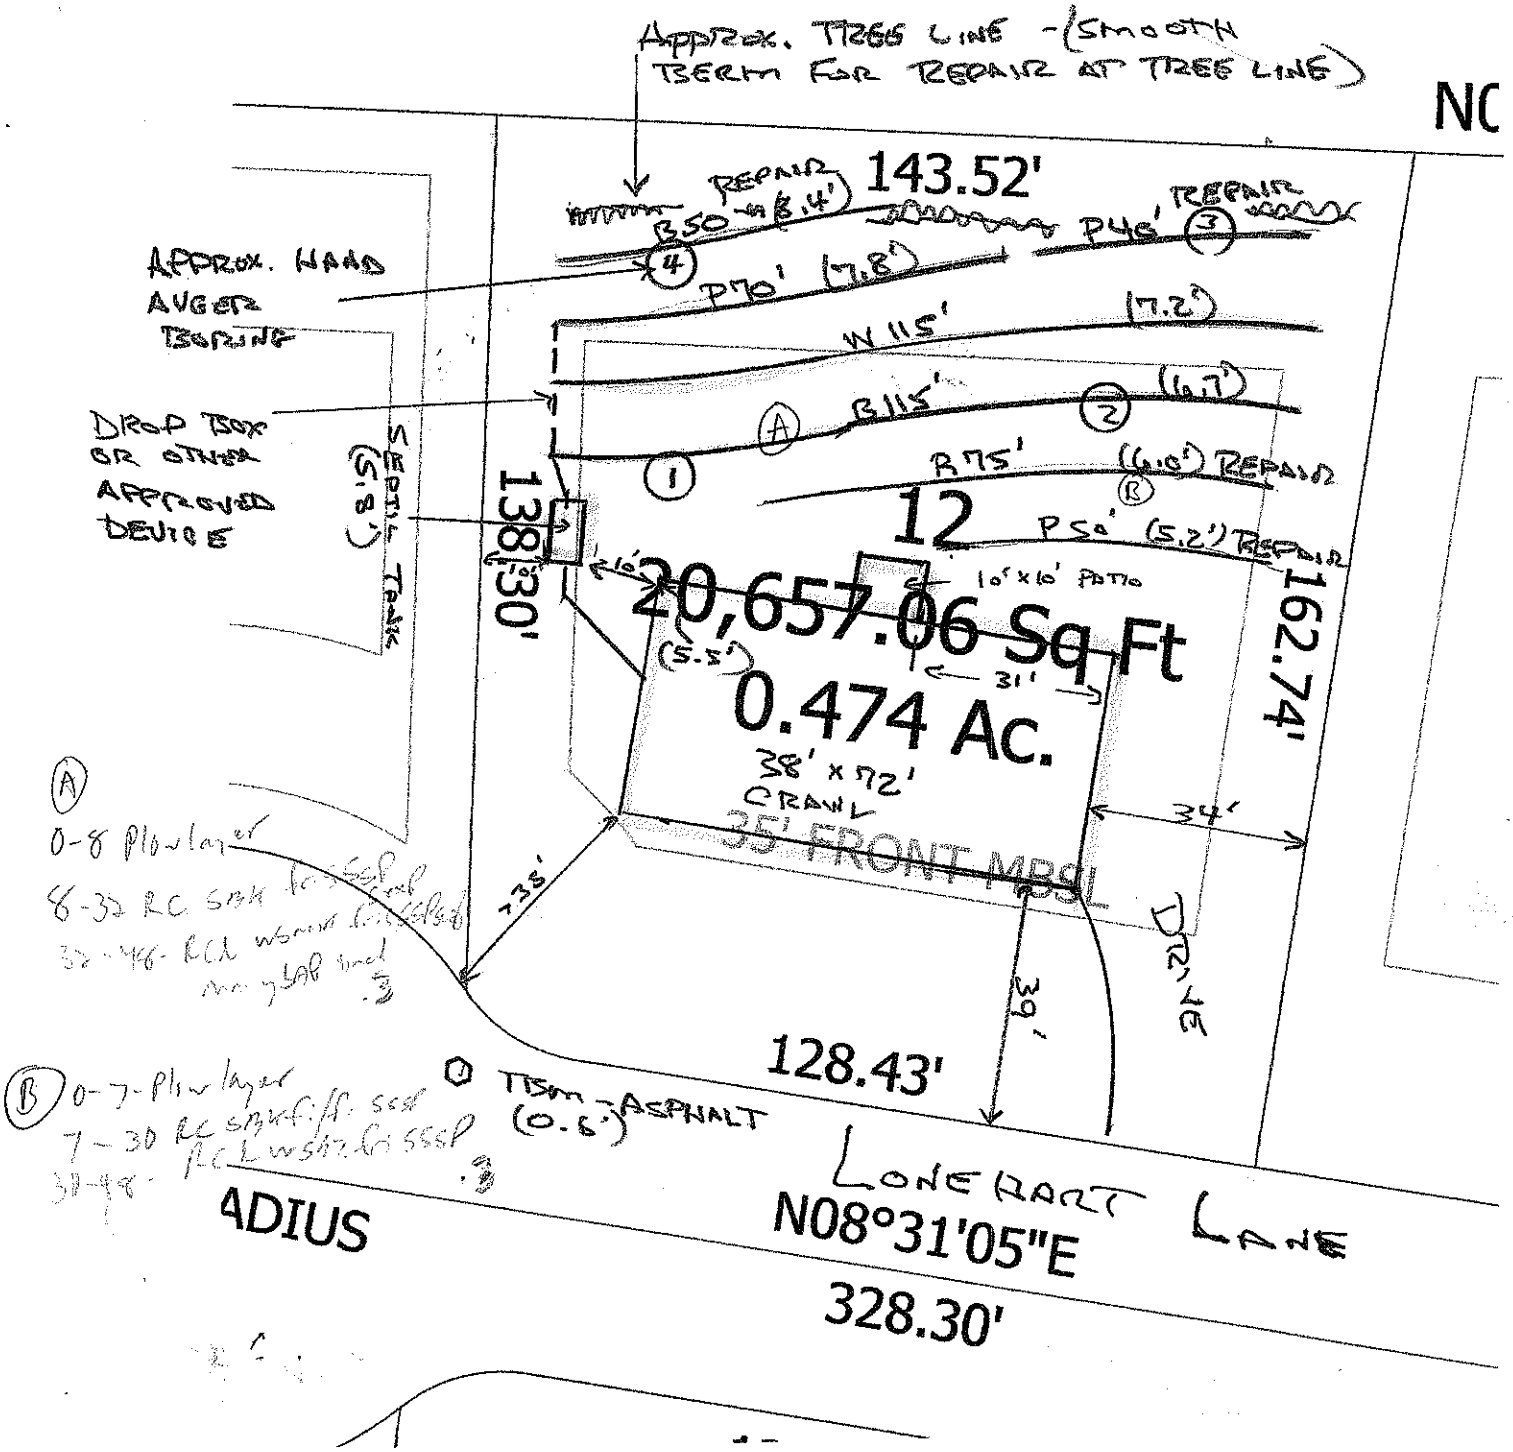

Bruce Porter – Lot 12 Lone Pine Meadows Expedited Review Septic Site Plan

Approximate septic and house pad locations - Refer to flagging in field. Owner to verify building setbacks. Site plan must accompany Penninger Soil Consulting, PLLC written report dated 6-22-16.