IREDELL COUNTY HEALTH DEPARTMENT

Statesville Office (704) 878-5305 Mooresville Office (704) 660-3625 PERMIT # 222287

IMPROVEMENT PERMIT / AUTHORIZATION TO CONSTRUCT / OPERATION PERMIT / EXISTING SYSTEM

PIN # 4765-80-1885

APPLICANT: Bruce Porter APPLICANT ADDRESS: 2143 Mocksville Hwy. Statesville

SITE ADDRESS: 137 Lonehart Ln. Statesville PHONE: 704-902-3124 ALT. PHONE:

SITE DIRECTIONS: Hwy 64, TR Lone Pine, TR Lone Hart, on R

SUBDIVISION: Lone Pine Meadows SECTION: LOT # 13 LOT AREA: .468 AC DESIGN FLOW: 360 L.T.A.R.: .25

Septic Tank 1000 (gal) STB 1160 Date 10-20-16

Pump Tank (gal) PT Date

Pump Make Model Serial #

Nitrification Fields 1 # Lines 4 Linear Ft: 360'

Trench Width 36" Max. Trench Bottom Depth 36" Highside Gravel Depth —

☒ New System ☐ Repair ☐ Expansion System Type: I II (III) IV V VI

System Description: 25% Reduction

Repair System Description: Panel Block

Maintenance Agreement Required: ☐ YES ☒ NO

☒ GRAVITY ☐ PRESSURE

☒ Residence ☐ Business ☐ Other ☒ Slab ☐ Basement w/plumbing

No. Bedrooms 3 No. Persons 6 No. Employees

☒ Crawl Space ☐ Basement w/o plumbing

Water Supply: ☐ Private ☒ Public ☐ Community

Comments / Conditions:

INITIAL SITE SKETCH

See Plan From Penninger Soil Consulting

AS BUILT SKETCH

Used Quick 4

Permit can be suspended or revoked if any false information is supplied toward securing the permit / any unauthorized changes are made to the site / any unauthorized changes are made in the installation of the system. **CONTACT A LOCATOR SERVICE PRIOR TO ANY EXCAVATION**


☐ **IMPROVEMENT PERMIT** *with plat valid without expiration.* ☒ **IMPROVEMENT PERMIT** *with site plan valid for 60 mos.* ☒ **AUTHORIZATION TO CONSTRUCT** *valid for period equal to IMPROVEMENT PERMIT--not to exceed 60 mo.*

Owner / Applicant Signature: Bruce Porter Date: 10-20-16 Installed by: Tommy Cothren

IMPROVEMENT PERMIT by: Date: 10-17-16 OPERATION PERMIT by: Maria Dotson Date: 2-1-17

AUTHORIZATION TO CONSTRUCT by: Date: 10-17-16 Existing System Inspected by: Date:

Health Dept. Copy - WHITE Applicant (Final Approval) - YELLOW Applicant (Conditional Approval) - PINK

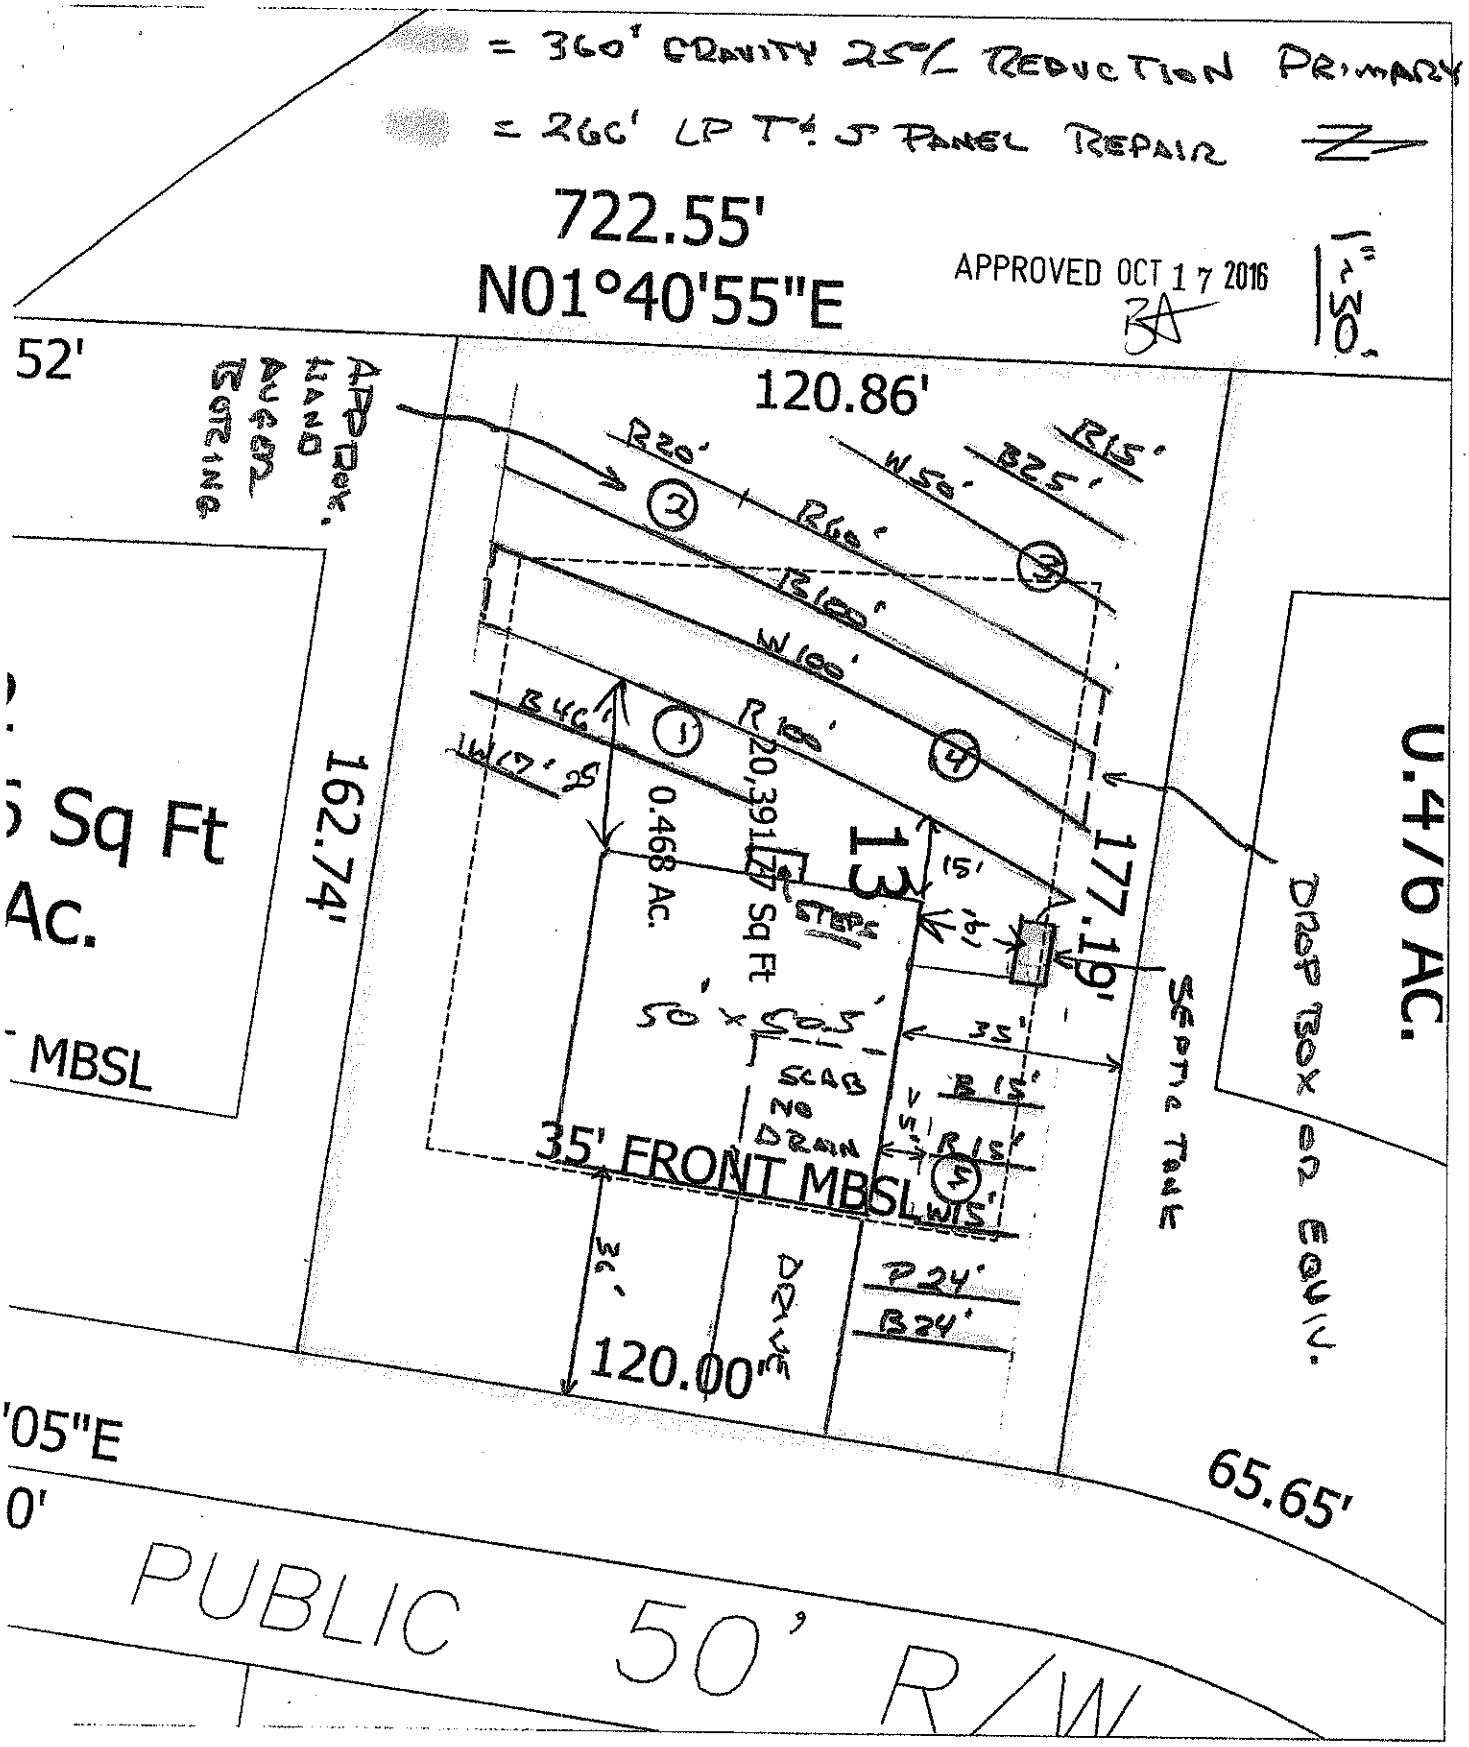

* SITE PLAN INVST ACCOMPANY PERMANENT SOIL CONSULTING WELTER REPORT DATED 10-5-16

Lot 13 Lone Pine Meadows Septic

Site Plan - Bruce Porter - 10-5-16