IREDELL COUNTY HEALTH DEPARTMENT

Statesville Phone TR 3-7271 — Mooresville Phone NO 3-1271

PERMIT TO INSTALL SEPTIC TANK

Permit NO. _____ Permit Date MARCH 15 1958

Owner CHARLIE EDWARDS Address STATESVILLE

Installed By C. HOKE Address _____


Location of Property OUT MOCKSVILLE ROAD - JUST BEYOND BEAVERS STORE 1st DIRT ROAD RIGHT 2ND HOUSE ON RIGHT

Tank		Capacity		Length of Lines		Fixtures	
Block	( )	800	( )	150'	( )	No. of Baths	(1)
Precast	(✓)	900	( )	175'	( )	Dishwasher	( )
		1000	(✓)	200'	( )	Garbage Grdr.	( )
		1100	( )	225'	( )	Auto-Washer	( )
		1200	( )	250'	( )	Other _____	
		Other _____		Other _____			

NOTIFY HEALTH DEPARTMENT AT LEAST EIGHT HOURS BEFORE TANK IS TO BE INSPECTED.

Final Inspection MARCH 15 1958 Approved (✓) Disapproved ( )

Remarks _____

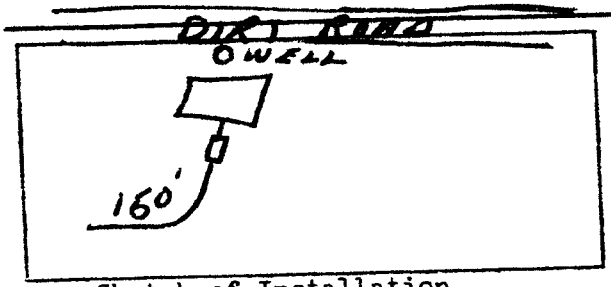

Sketch of Installation

R. W. J.

Sanitarian