IREDELL COUNTY HEALTH DEPARTMENT

STATESVILLE 704-878-5305 MOORESVILLE 704-664-5281

IMPROVEMENT PERMIT / AUTHORIZATION TO CONSTRUCT / OPERATION PERMIT / EXISTING SYSTEM INSPECTION

PERMIT# REPAIR PIN# 4765-~~70-8668~~ 80-4355 DATE 3-17-04

OWNER OR CONTRACTOR PRISCILLA DOBBINS PHONE: Business Home 704-871-0471

ADDRESS 106 CONE LANE, STATESVILLE, NC 28625

LOCATION US 64 EAST, TR LONE PINE ROAD, .07 MILE ON RIGHT AT CONE LANE

SUBDIVISION BLOCK / SECTION LOT LOT AREA 14.75 ACRES SITE CLASS. PS DESIGN FLOW 240 L.T.A.R. 0.30 GPD/FT2

Septic Tank: EXISTING Gallons: STB Date

Pump Tank: Gallons: PT Date

Pump Make: Model Serial No.

Nitrification Field: No Fields 1 Square Feet 360 Linear Feet 120

No Lines TWO Trench Width 36" Max Trench Bottom Depth 36"

☐ New System ☑ Repair System Type: I (II), III, IV, V, VI

System Description:

Repair System Description: CONVENTIONAL, GRAVITY

Maintenance ~~Agreement Required~~ ☐ Yes ☑ No

Gravel Depth 18" ☐ Slab ☑ Crawl Space ☐ Basement w/plumbing ☐ Basement wo/plumbing

☑ House/Mod. Home No. Bedrooms 3

☐ Mobile Home No. Bathrooms 1

☐ Business No. Employees


☐ Other

Water Supply: ☑ Individual ☐ Public ☐ Community WELL


Comments/Conditions: (1) INSTALL NEW SANITARY TEE IN SEPTIC TANK (2) INSTALL NEW DISTRIBUTION BOX AS SHOWN (3) INSTALL TWO NEW 3' x 60' LINES AS FLAGGED USING 18" STONE

Comments/Conditions: (4) THIS PERMIT SERVES AS "NOTICE OF VIOLATION." SYSTEM TO BE REPAIRED BY 4-19-04

INITIAL SITE SKETCH

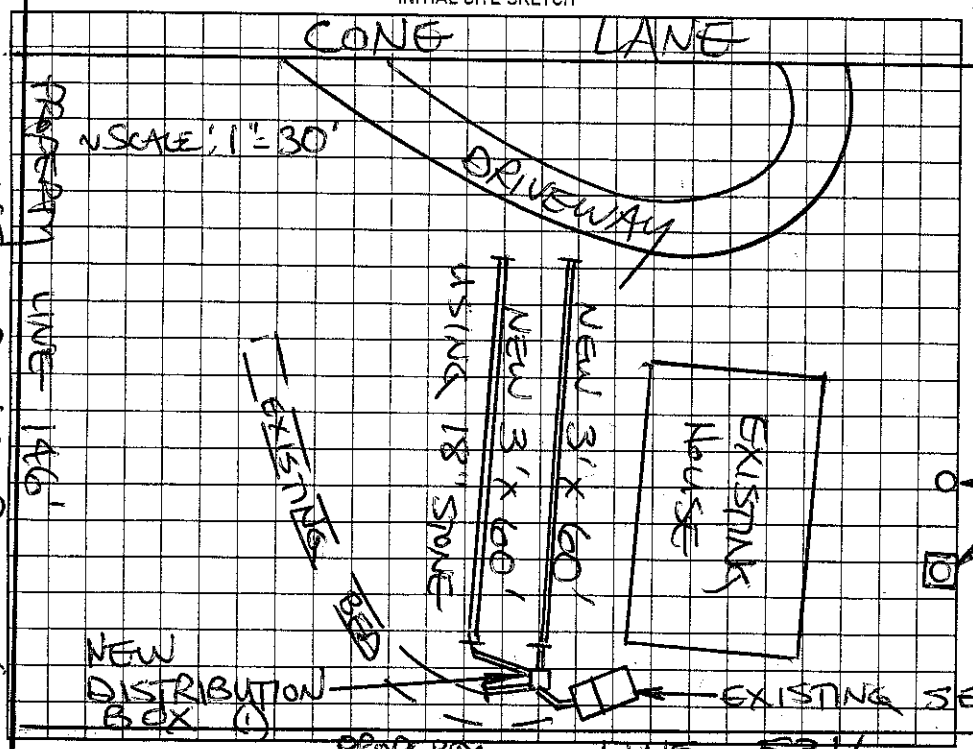

AS BUILT SKETCH

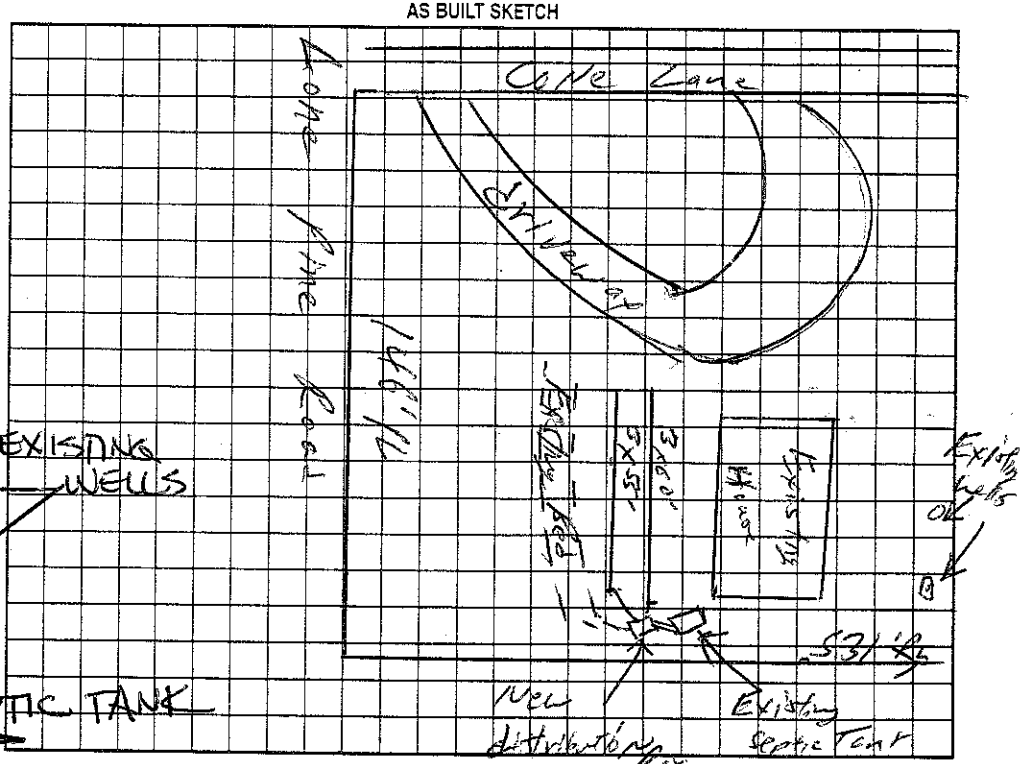

Permit can be suspended or revoked if any false information is supplied toward securing the permit/any unauthorized changes are made to the site/any unauthorized changes are made in the installation of the system. Improvement Permit with plat valid without expiration. Improvement Permit with site plan valid for sixty months. Authorization to Construct is valid for a period equal to that of Improvement Permit – not to exceed sixty months.

Signed: + Priscilla Dobbins date 3-17-04

Improvement Permit by: STEVE HEDRICK date 3-17-04

Authorization to Construct by: STEVE HEDRICK date 3-17-04

Installed by: James Hasler

Operation Permit by: William C. Johnson date 4/19/04

Existing System Inspection by: date

HEALTH DEPT. COPY: WHITE OWNER COPY (FINAL): YELLOW OWNER COPY (INITIAL): PINK