FILE COPY

IREDELL COUNTY HEALTH DEPARTMENT

Statesville Office (704) 878-5305 Mooresville Office (704) 660-3625

IMPROVEMENT PERMIT / AUTHORIZATION TO CONSTRUCT / OPERATION PERMIT / EXISTING SYSTEM

PERMIT # 201993

APPLICANT: Steve Hart

PIN # 4765805367

APPLICANT ADDRESS: P.O. Box 64 Stein hatchee FL 32359

SITE ADDRESS: 260 Lone Pine Rd Statesville NC 28625 PHONE: 704-902-3124 ALT. PHONE: 352-672-3132

SITE DIRECTIONS: 64E T/R on Lone Pine Rd 8th Lot on Right

SUBDIVISION: Lone Pine Meadows SECTION: P2 LOT # 8 LOT AREA: 0.47ac DESIGN FLOW: 360 L.T.A.R.: .3

Septic Tank	1000 (gal)	STB 160-1000	Date 6-24-14	☒ New System ☐ Repair ☐ Expansion	System Type: I II (III) IV V VI
Pump Tank	(gal)	PT	Data	System Description: 25% Reduction	
Pump Make		Model	Serial #	Repair System Description: 50% Reduction Pump	
# Nitrification Fields	1	# Lines 6	Linear Ft: 322	Maintenance Agreement Required:	☐ YES ☒ NO
Trench Width	36"	Max. Trench Bottom Depth 36"	Gravel Depth N/A		☒ GRAVITY ☐ PRESSURE

☐ Residence ☐ Business ☐ Other ☐ Slab ☐ Basement w/plumbing


No. Bedrooms 3 No. Persons 6 No. Employees ☒ Crawl Space

Water Supply: ☐ Private ☐ Public ☒ Community


☐ Basement w/o plumbing

Comments / Conditions: Install 25% on Contour with Serial distribution. Maintain 10' off water line.

INITIAL SITE SKETCH

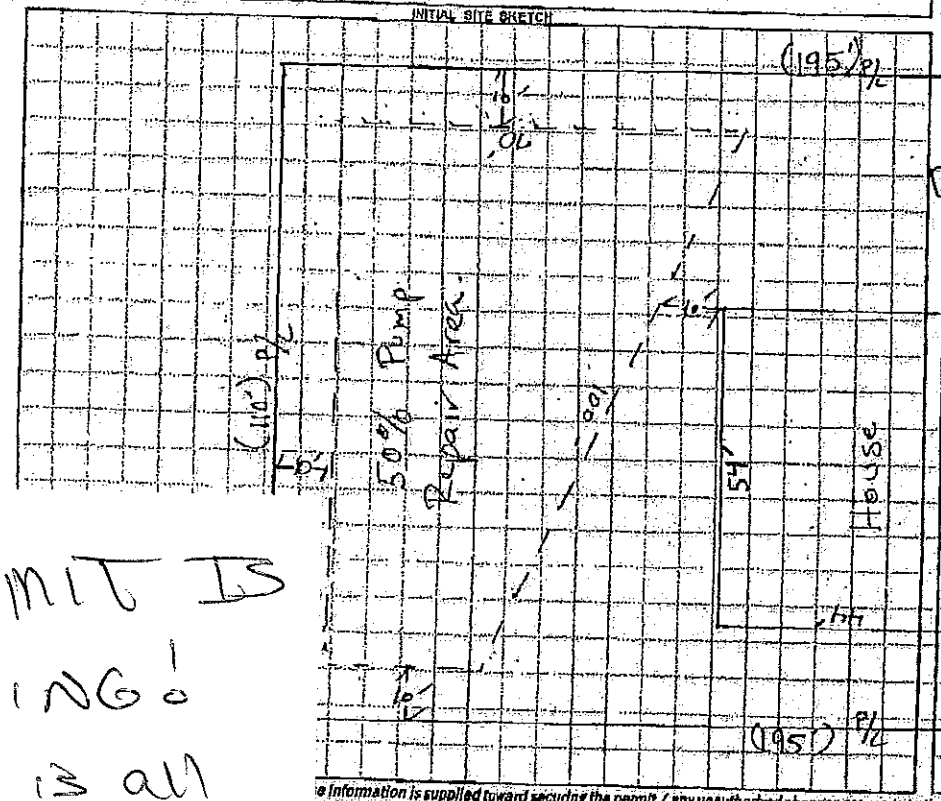

AS BUILT SKETCH

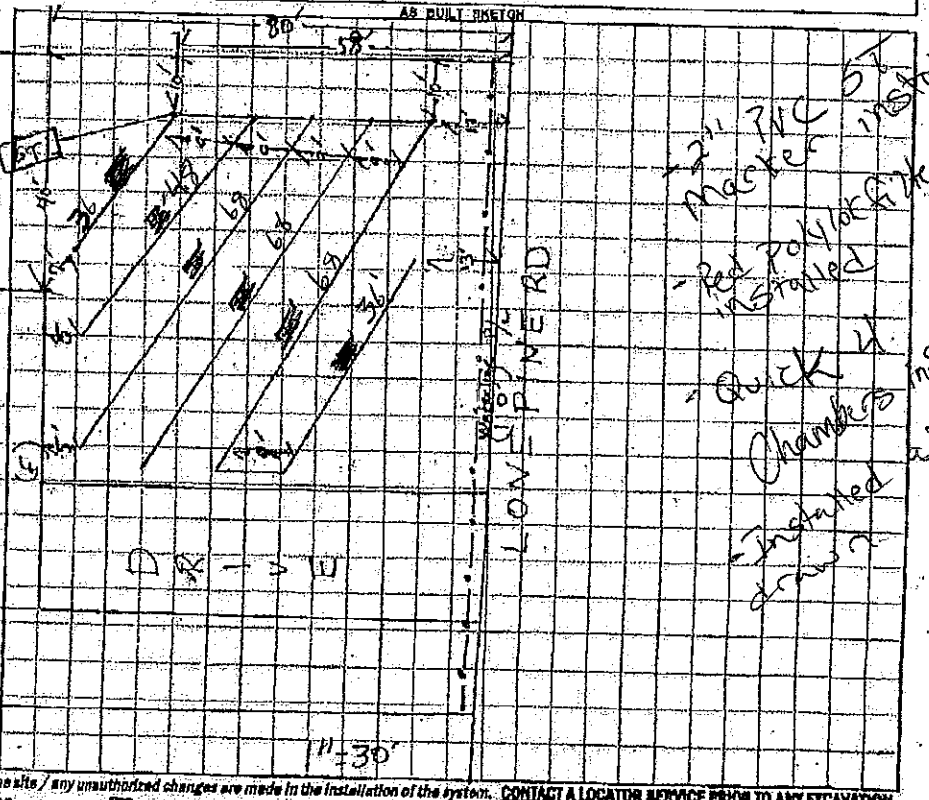

...e information is supplied toward securing the permit / any unauthorized changes are made to the site / any unauthorized changes are made in the installation of the system. CONTACT A LOCATOR SERVICE PRIOR TO ANY EXCAVATION

...alid without expiration. ☒ IMPROVEMENT PERMIT with site plan valid for 60 mos. ☒ AUTHORIZATION TO CONSTRUCT valid for period equal to IMPROVEMENT PERMIT--not to exceed 60 mo.

Date: 3-24-14 Installed by: Tommy Cotheran & Son

Date: 03/20/14 OPERATION PERMIT by: Brett Henderson Date: 9-2-14

Date: 03/20/14 Existing System Inspected by: Date:

Health Dept. Copy - WHITE Applicant (Final Approval) - YELLOW Applicant (Conditional Approval) - PINK

PERMIT IS MISSING! This is all I have JM

p.2

7048789314