IREDELL COUNTY HEALTH DEPARTMENT

STATESVILLE 704-878-5305 MOORESVILLE 704-664-5281

IMPROVEMENT PERMIT / AUTHORIZATION TO CONSTRUCT / OPERATION PERMIT / EXISTING SYSTEM INSPECTION

PERMIT# 80527 PIN# 4765810539 DATE 4-14-99

OWNER OR CONTRACTOR Michael Maine PHONE: Business _____ Home 8736735

ADDRESS 151 Kellana Dr.

LOCATION Mocksville Hwy (US64E) TR Lone Pine TR Kellana at end on left

SUBDIVISION _____ BLOCK / SECTION _____ LOT _____ LOT AREA 2.21 acres SITE CLASS PS DESIGN FLOW 360 L.T.A.R. .3

Septic Tank: 1000 Gallons: STB 628 Date 7-16-99

Pump Tank: _____ Gallons: PT _____ Date _____

Pump Make: _____ Model _____ Serial No. _____

Nitrification Field: No Fields 1 Square Feet 900 Linear Feet 300

No Lines 4 Trench Width 36" Max Trench Bottom Depth 36" Gravel Depth N/A

New System ☐ Repair System Type: I, II, III, IV, V, VI

System Description: Gravity 25% red.

Repair System Description: Pump To Conv.

Maintenance Agreement Required: ☐ Yes ☑ No

☑ House/Mod. Home No. Bedrooms 3

☐ Mobile Home No. Bathrooms 2

☐ Business No. Employees _____

☐ Other _____


☐ Slab ☑ Crawl Space ☐ Basement w/plumbing ☐ Basement wo/plumbing

Water Supply: ☑ Individual ☐ Public ☐ Community


Comments/Conditions:

Comments/Conditions

INITIAL SITE SKETCH

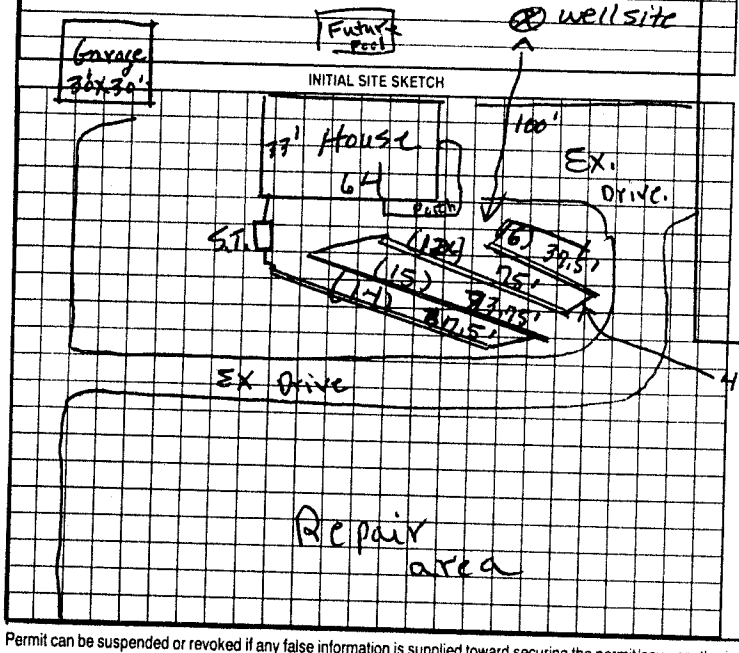

AS BUILT SKETCH

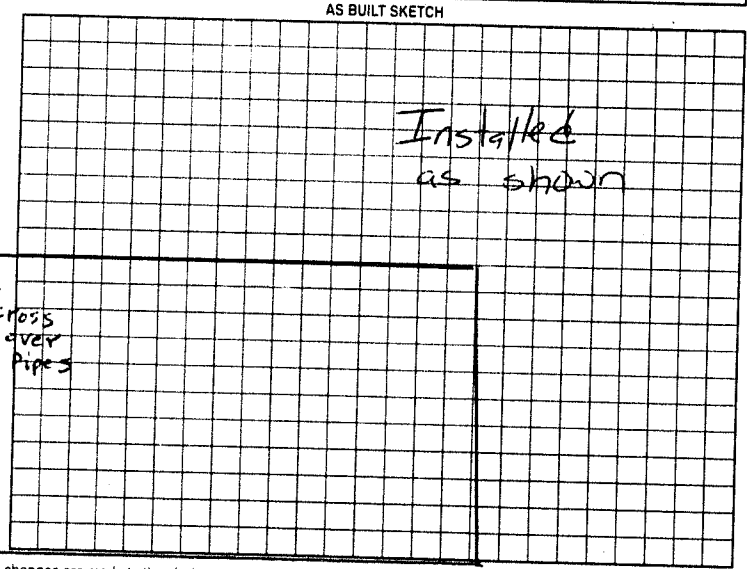

Permit can be suspended or revoked if any false information is supplied toward securing the permit/any unauthorized changes are made to the site/any unauthorized changes are made in the installation of the system. Improvement Permit with plat valid without expiration. Improvement Permit with site plan valid for sixty months. Authorization to Construct is valid for a period equal to that of Improvement Permit – not to exceed sixty months.

Signed: Elizabeth Maine date 4/15/99 Installed by: K+L Septic

Improvement Permit by: P. C. Moore date 4-14-99 Operation Permit by: [illegible] date 8-27-99

Authorization to Construct by: P. C. Moore date 4-14-99 Existing System Inspection by: _____ date _____

HEALTH DEPT COPY WHITE OWNER COPY (FINAL) YELLOW OWNER COPY (INITIAL) PINK