IREDELL COUNTY HEALTH DEPARTMENT

Statesville Office (704) 878-5305 Mooresville Office (704) 660-3625 PERMIT # 210968

IMPROVEMENT PERMIT / AUTHORIZATION TO CONSTRUCT / OPERATION PERMIT / EXISTING SYSTEM

PIN # 4765817006

APPLICANT: Bruce Porter APPLICANT ADDRESS: 2143 Mocksville Hwy

SITE ADDRESS: 240 Lone Pine Rd. PHONE: 704-902-3124 ALT. PHONE: N/A

SITE DIRECTIONS: Hwy 64 E TR Lone Pine Rd. Property on Right


SUBDIVISION: Lone Pine Meadows SECTION: N/A LOT # 5 LOT AREA: 0.556 acres DESIGN FLOW: 360 gpd L.T.A.R.: 0.25

Septic Tank	1000	(gal)	STB	760-1000	Date	8-6-15	☑ New System	☐ Repair	☐ Expansion	System Type: I II (III) IV V VI	
Pump Tank		(gal)	PT		Date		System Description:	25% Reduction			
Pump Make			Model		Serial #		Repair System Description:	25% Reduction			
# Nitrification Fields	1	# Lines	5	Linear Ft:	364		Maintenance Agreement Required:	☐ YES	☑ NO		
Trench Width	36"	Max. Trench Bottom Depth	36"	Gravel Depth	N/A		☑ GRAVITY	☐ PRESSURE			


☑ Residence	No. Bedrooms	3	Water Supply	
☐ Business	No. Persons	6	☐ Private	
☐ Other	No. Employees		☑ Public	
☐ Slab	☑ Crawl Space		☐ Community	
☐ Basement w/plumbing			☐ Basement w/o plumbing	

Comments / Conditions: Install a 25% Reduction system on contour with serial distribution. ☆☆ Install trench bottom @ 36" on high side ☆☆☆

INITIAL SITE SKETCH

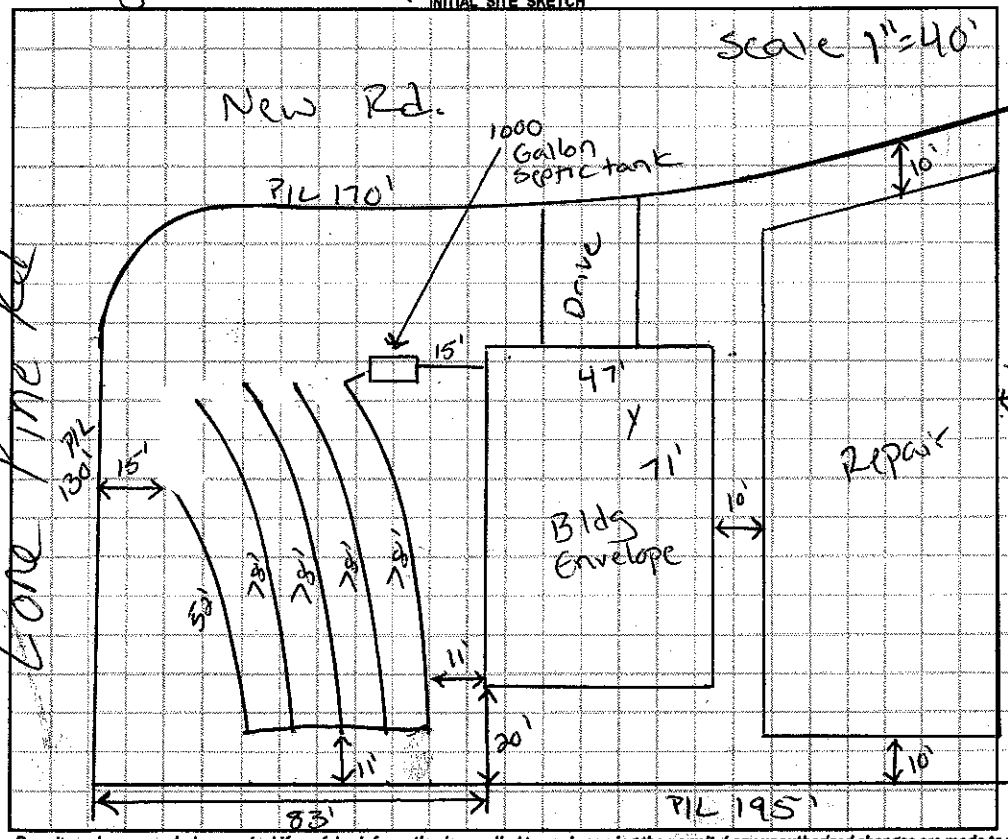

AS BUILT SKETCH

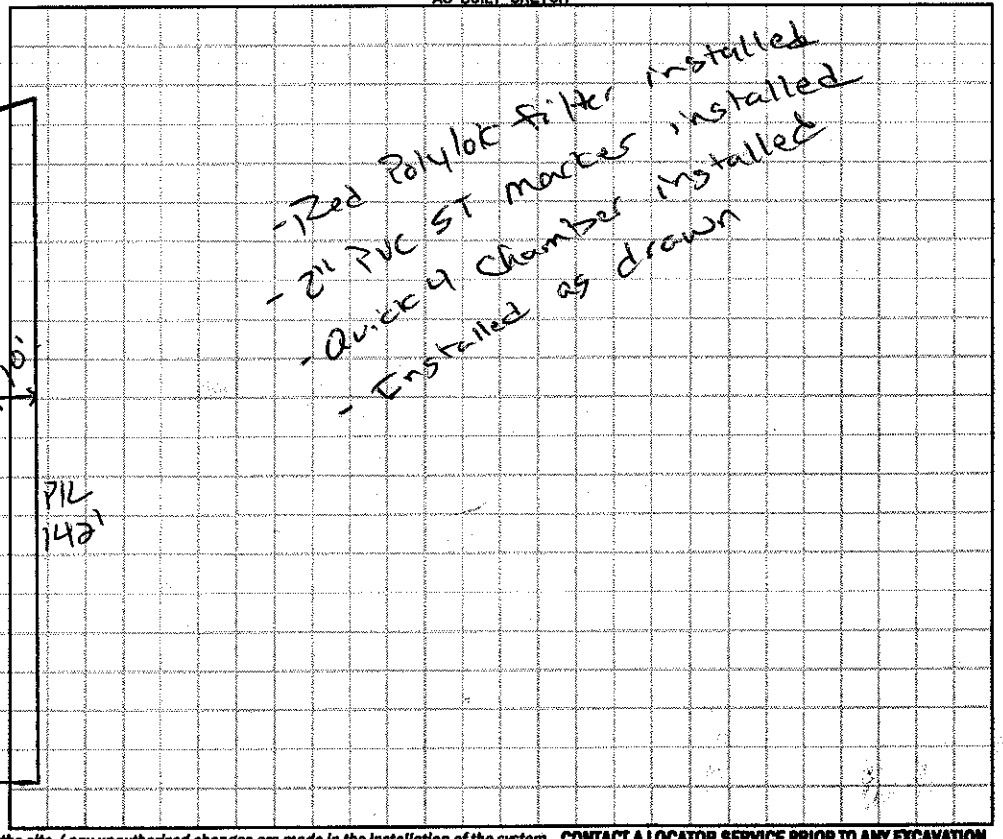

Permit can be suspended or revoked if any false information is supplied toward securing the permit / any unauthorized changes are made to the site / any unauthorized changes are made in the installation of the system. **CONTACT A LOCATOR SERVICE PRIOR TO ANY EXCAVATION**

☐ **IMPROVEMENT PERMIT** *with plat valid without expiration.* ☑ **IMPROVEMENT PERMIT** *with site plan valid for 60 mos.* ☑ **AUTHORIZATION TO CONSTRUCT** *valid for period equal to IMPROVEMENT PERMIT--not to exceed 60 mo.*

Owner / Applicant Signature: Bruce Porter Date: 6-23-15 Installed by: Catherion Tsan

IMPROVEMENT PERMIT by: Justin Henderson Date: 6-23-15 OPERATION PERMIT by: Catherion Tsan Justin Henderson Date: 10-30-15

AUTHORIZATION TO CONSTRUCT by: Justin Henderson Date: 6-23-15 Existing System Inspected by: Date:

Health Dept. Copy - WHITE Applicant (Final Approval) - YELLOW Applicant (Conditional Approval) - PINK