WINDOW SCHEDULE

SYMBOL □

MARK	ROUGH OPNG	DESCRIPTION	PELLA NO.	QUAN.
A	1'-2 1/2" x 3'-6"	CASEMENT	DCB321 2344-2	1
B	5'-6" x 6'-3 1/4"	EQUILE HDRS	EQUILDH 3375-2	1
C	5'-6" DIAGSTEP	CIRCLEHEAD	SPECIAL	1
D	5'-6" x 5'-3 1/4"	DOUBLE HDRS	EQUILDH 3363-2	3
E	2'-5 1/4" x 5'-3 1/4"	DOUBLE HDRS	EQUILDH 3363	6

ALL WINDOWS ARE INSULATED AND WEATHERSTRIPPED AS MANUFACTURED BY "PELLA" (ROLLSCREEN CO., PELLA, IOWA 50219)

VERIFY LOCAL CODE EGRESS WINDOW REQUIREMENTS PRIOR TO CONSTRUCTION.


VERIFY WINDOW MODEL NUMBERS AND SIZES WITH MANUFACTURER BEFORE STARTING CONSTRUCTION

DOOR SCHEDULE

SYMBOL ( )

MARK	SIZE	DESCRIPTION	QUAN.
1	3'-0" x 6'-8" x 1 3/4"	EXT. HARDWOOD w/ 12" SIDELIGHT	1
2	2'-8" x 6'-8" x 1 3/8"	INT. HARDWOOD	2
3	5'-0" x 6'-8" x 1 3/8"	INT. BI-FOLD	2
4	2'-4" x 6'-8" x 1 3/8"	INT. HARDWOOD	1
5	2'-8" x 6'-8" x 1 3/8"	INT. HARDWOOD	1
6	(2) 2'-6" x 6'-8" x 1 3/8"	INT. HARDWOOD	1
7	2'-0" x 6'-8" x 1 3/8"	INT. HARDWOOD	1
8	2'-8" x 6'-8" x 1 3/8"	INT. POCKET	1
9	2'-8" x 6'-8" x 1 3/4"	EXT. HARDWOOD - FRENCH	1
10	2'-8" x 6'-8" x 1 3/4"	EXT. HARDWOOD - 1 HOUR RATED	1
11	16'-0" x 7'-0"	GARAGE	1
12	2'-6" x 6'-8" x 1 3/8"	INT. BI-FOLD	1

Reversed plan

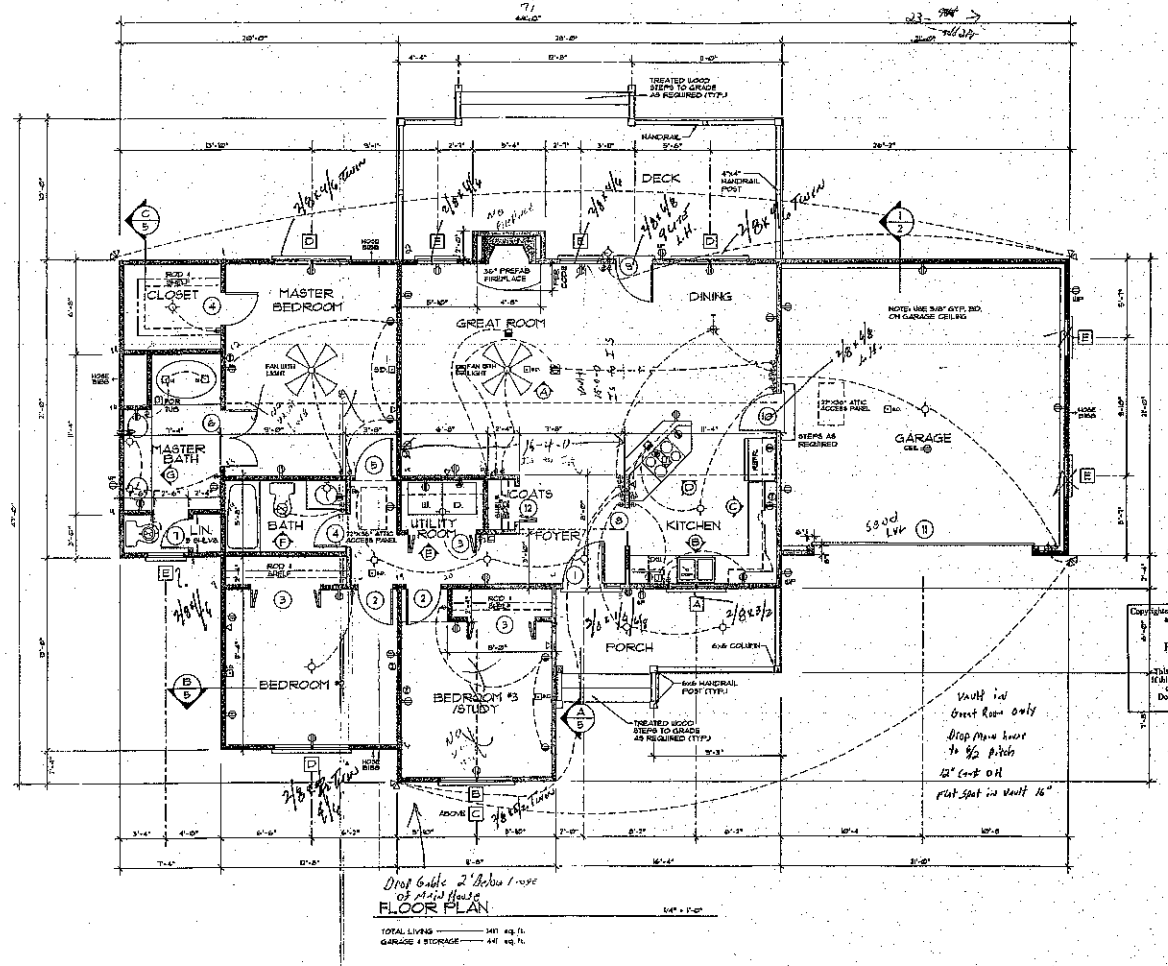

FLOOR PLAN

1/4" = 1'-0"

TOTAL LIVING ——— 1411 sq. ft.
GARAGE & STORAGE ——— 441 sq. ft.

ELECTRICAL LEGEND

SYMBOL	DESCRIPTION
	DUPLEX OUTLET (GROUNDED TYPE)
	WEATHER PROOF DUPLEX OUTLET
	WALL SWITCH CONTROLLED DUPLEX OUTLET
	ABOVE COUNTER LOCATION
	FLUSH FLOOR WALL SWITCH CONTROLLED DUPLEX OUTLET, OWNER VERIFY LOCATION
	220 VOLT OUTLET OR CONNECTION
	TELEVISION ANTENNA / CABLE OUTLET
	TELEPHONE OUTLET LOCATION
	DOOR CHIME LOCATION
	220 VOLT JUNCTION BOX
	SINGLE POLE WALL SWITCH
	SINGLE POLE WALL SWITCH WITH DIMMER
	3-WAY WALL SWITCH
	3-WAY WALL SWITCH WITH DIMMER
	CEILING MOUNTED LIGHT FIXTURE
	WALL BRACKET MOUNTED LIGHT FIXTURE
	SUSPENDED CEILING MOUNTED LIGHT FIXTURE
	RECESSED DIRECTIONAL CEILING LIGHT FIXTURE
	RECESSED CEILING LIGHT FIXTURE
	RECESSED LIGHT FOR WET AREA
	ONE TUBE UNDER COUNTER FLUORESCENT LIGHT
	EXTERIOR CAST ALUMINUM FLOOD LIGHTS
	CEILING MOUNTED FAN - PADDLE
	CEILING MOUNTED FAN - EXHAUST
	CEILING MOUNTED FAN AND HEATER
	PORCELAIN LAMPHOLDER
	DOOR BELL BUTTON
SMK.	SMOKE DETECTOR
	CEILING MOUNTED FAN, LIGHT, AND HEATER

ALL FEDERAL, STATE, AND LOCAL CODES, ORDINANCES, REGULATIONS ETC. SHALL BE CONSIDERED AS PART OF SPECIFICATIONS FOR THIS BUILDING AND SHALL TAKE PRECEDENCE OVER ANYTHING SHOWN, DESCRIBED, OR NOTED WHERE SAME ARE IN VARIANCE

Acknowledgement
Plans Submittal ONLY
Bruce Fort Date 6-22-15
Date 6-22-15

Copyrighted by Donald A. Gardner Architects, Inc and/or Donald A. Gardner, Inc

REG.#

"This stamp must appear in RED INK. If this stamp is not Red, this is an illegal copy. Report the illegal copy to Donald A. Gardner Architects, Inc 1-800-388-7580"

RED INK

Vault in Great Room only

NOTE:
VERIFY ALL LOCAL CODES, ENERGY TYPES, AND SITE CONDITIONS PRIOR TO CONSTRUCTION. REVISE SELECTED MECHANICAL SYSTEMS WITH OWNER PRIOR TO CONSTRUCTION. RECOMMENDED LOCATIONS ARE AS FOLLOWS: THE WATER HEATER MAY TYPICALLY BE PLACED IN THE CRAWL SPACE OR IN THE GARAGE. HVAC UNIT MAY TYPICALLY BE PLACED IN THE CRAWL SPACE OR ATTIC SPACE. HVAC EQUIPMENT IN ATTIC SPACE SHALL BE ACCESSIBLE BY AN OPENING AS LARGE AS THE LARGEST PIECE OF EQUIPMENT AND IN NO CASE LESS THAN 22"x36".

SEE STRUCTURAL DRAWINGS FOR ADDITIONAL INFORMATION.

INSULATE AROUND ALL BATHS AND UTILITY ROOM.

TYPICAL WALL 2x4'S @ 16" O.C. UNLESS OTHERWISE DIMENSIONED

DONALD A. GARDNER
ARCHITECTS, INC.
P.O. BOX 26178 • GREENVILLE, S.C. - 29616
864 • 288 • 7580
www.dongardner.com

DESIGN NO. 4113-HR
SHEET 3 OF 6
FLOOR PLAN

DO NOT SCALE DRAWINGS.
COPYRIGHT © 10/9/95 ALL RIGHTS RESERVED BY DONALD A. GARDNER, ARCHITECT, INC. NOT TO BE COPIED OR REPRODUCED WITHOUT WRITTEN PERMISSION.