IREDELL COUNTY HEALTH DEPARTMENT

Statesville Office (704) 878-5305 Mooresville Office (704) 660-3625 PERMIT # 200421

IMPROVEMENT PERMIT / AUTHORIZATION TO CONSTRUCT / OPERATION PERMIT / EXISTING SYSTEM

PIN # 4765817156

APPLICANT: Bruce Porter APPLICANT ADDRESS: 2143 Mocksville Hwy

SITE ADDRESS: 234 Lone Pine Rd. PHONE: 704-902-3124 ALT. PHONE: N/A

SITE DIRECTIONS: Hwy 64 E TR Lone Pine Rd.

SUBDIVISION: Lone Pine Meadows SECTION: P2 LOT # 4 LOT AREA: 0.49 acres DESIGN FLOW: 360gpd L.T.A.R.: 0.25

Septic Tank	1000 (gal)	STB	160	Date	4/9/14	☑ New System ☐ Repair ☐ Expansion	System Type: I II ☒ III IV V VI
Pump Tank	N/A (gal)	PT	N/A	Date	N/A	System Description:	25% Reduction
Pump Make	N/A	Model	Poly Tank	Serial #	PL-68	Repair System Description:	Low Pressure PPBPS
# Nitrification Fields	1	# Lines	6	Linear Ft:	360	Maintenance Agreement Required:	☐ YES ☑ NO
Trench Width	36"	Max. Trench Bottom Depth	36"	Gravel Depth	N/A	☑ GRAVITY	☐ PRESSURE


☑ Residence ☐ Business ☐ Other ☐ Slab ☐ Basement w/plumbing

No. Bedrooms 3 No. Persons 6 max No. Employees ☑ Crawl Space ☐ Basement w/o plumbing

Water Supply: ☐ Private ☑ Public ☐ Community

Comments / Conditions: Install a 25% Reduction system on contour with serial distribution. Do NOT cut for house site, backfill to achieve positive drainage. Water line shall be a minimum of 10' away from all components of septic tank system & repair area.

INITIAL SITE SKETCH

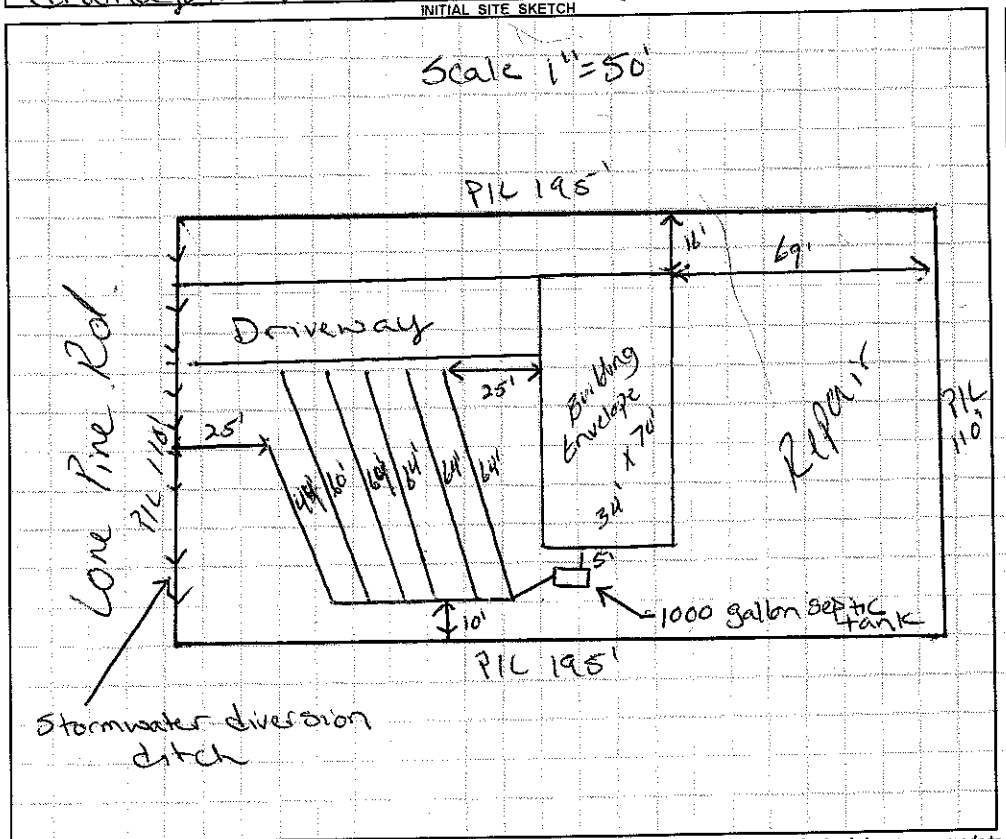

AS BUILT SKETCH

Installed Qwik 4 as drawn

Permit can be suspended or revoked if any false information is supplied toward securing the permit / any unauthorized changes are made to the site / any unauthorized changes are made in the installation of the system. **CONTACT A LOCATOR SERVICE PRIOR TO ANY EXCAVATION**

☐ **IMPROVEMENT PERMIT** *with plat valid without expiration.* ☑ **IMPROVEMENT PERMIT** *with site plan valid for 60 mos.* ☑ **AUTHORIZATION TO CONSTRUCT** *valid for period equal to IMPROVEMENT PERMIT--not to exceed 60 mo.*

Owner / Applicant Signature: Bruce Porter Date: 12-16-13 Installed by: Cothran & Son Grading

IMPROVEMENT PERMIT by: Justin Henderson Date: 12-17-13 OPERATION PERMIT by: Date: 05/21/14

AUTHORIZATION TO CONSTRUCT by: Justin Henderson Date: 12-17-13 Existing System Inspected by: Date:

Health Dept. Copy - WHITE Applicant (Final Approval) - YELLOW Applicant (Conditional Approval) - PINK