EDELL COUNTY HEALTH DEPARTMENT

Statesville Office (704) 878-5305 Mooresville Office (704) 660-3625 PERMIT # 21920

PROVEMENT PERMIT / AUTHORIZATION TO CONSTRUCT / OPERATION PERMIT / EXISTING SYSTEM

PIN # 4765817257

APPLICANT: WCU INC APPLICANT ADDRESS: Po Box Stanhatchee FL 32359

SITE ADDRESS: 228 Lone Pine Rd. PHONE: 352-672-3132 ALT. PHONE: N/A

SITE DIRECTIONS: Hwy 64E TR Lone Pine Rd.

SUBDIVISION: Lone Pine Meadows SECTION: 2 LOT # 3 LOT AREA: 0.772 acres DESIGN FLOW: 360gpd L.T.A.R.: 0.25

Septic Tank	1000 (gal)	STB	166-1000	Date	12-11-15	☑ New System	☐ Repair	☐ Expansion	System Type: I II (III) IV V VI	☑ Residence	No. Bedrooms 3
Pump Tank	1000 (gal)	PT	149	Date	10-26-15	System Description:	Conventional / Approved			☐ Business	No. Persons 6
Pump Make	Zoeller	Model	N152-B	Serial #		Repair System Description:	TS-1 DRIP			☐ Other	No. Employees
# Nitrification Fields	1	# Lines	3	Linear Ft:	450	Maintenance Agreement Required:	☐ YES	☑ NO		☐ Slab	☑ Crawl Space
Trench Width	36"	Max. Trench Bottom Depth	48"	Gravel Depth	12"		☐ GRAVITY	☑ PRESSURE		☐ Basement w/plumbing	☐ Basement w/o plumbing

Water Supply: ☐ Private ☑ Public ☐ Community

Comments / Conditions: Improvements Only ! Sub-divide * record new Proposed Lot lines prior to issuance of CA. If approved system is installed NO REDUCTION IS GIVEN !!

INITIAL SITE SKETCH

See attached plan by:

Penninger Soil Consulting, PLLC

AS BUILT SKETCH

- Red Polylok filter installed
- 2" ST marker installed
- Quick 4 chambers installed
- 1½" Sch 80 Tee installed
- Pressure Head set @ 3'

	Date	Initials
Drain Lines Checked	3-2-16	JW
Tanks Checked	3-2-16	JW
Pressure Manifold or Valve Box Checked	3-2-16	JW
Pressure Head Set	3-2-16	JW
Electrical Checked	4-1-16	JW
Floats Set	4-1-16	JW
Alarm Checked	4-1-16	JW
Maintenance Contract Y / N	N/A	

Permit can be suspended or revoked if any false information is supplied toward securing the permit / any unauthorized changes are made to the site / any unauthorized changes are made in the installation of the system. CONTACT A LOCATOR SERVICE PRIOR TO ANY EXCAVATION


☐ **IMPROVEMENT PERMIT** *with plat valid without expiration.* ☑ **IMPROVEMENT PERMIT** *with site plan valid for 60 mos.* ☑ **AUTHORIZATION TO CONSTRUCT** *valid for period equal to IMPROVEMENT PERMIT--not to exceed 60 mo.*

Owner / Applicant Signature: Bruce Post Date: 7-31-15 Installed by: Cotherar & Son

IMPROVEMENT PERMIT by: Justin Henderson Date: 7-20-15 OPERATION PERMIT by: Justin Henderson Date: 4-1-16

AUTHORIZATION TO CONSTRUCT by: Justin Henderson Date: 8-14-15 Existing System Inspected by: Date:

Health Dept. Copy - WHITE Applicant (Final Approval) - YELLOW Applicant (Conditional Approval) - PINK

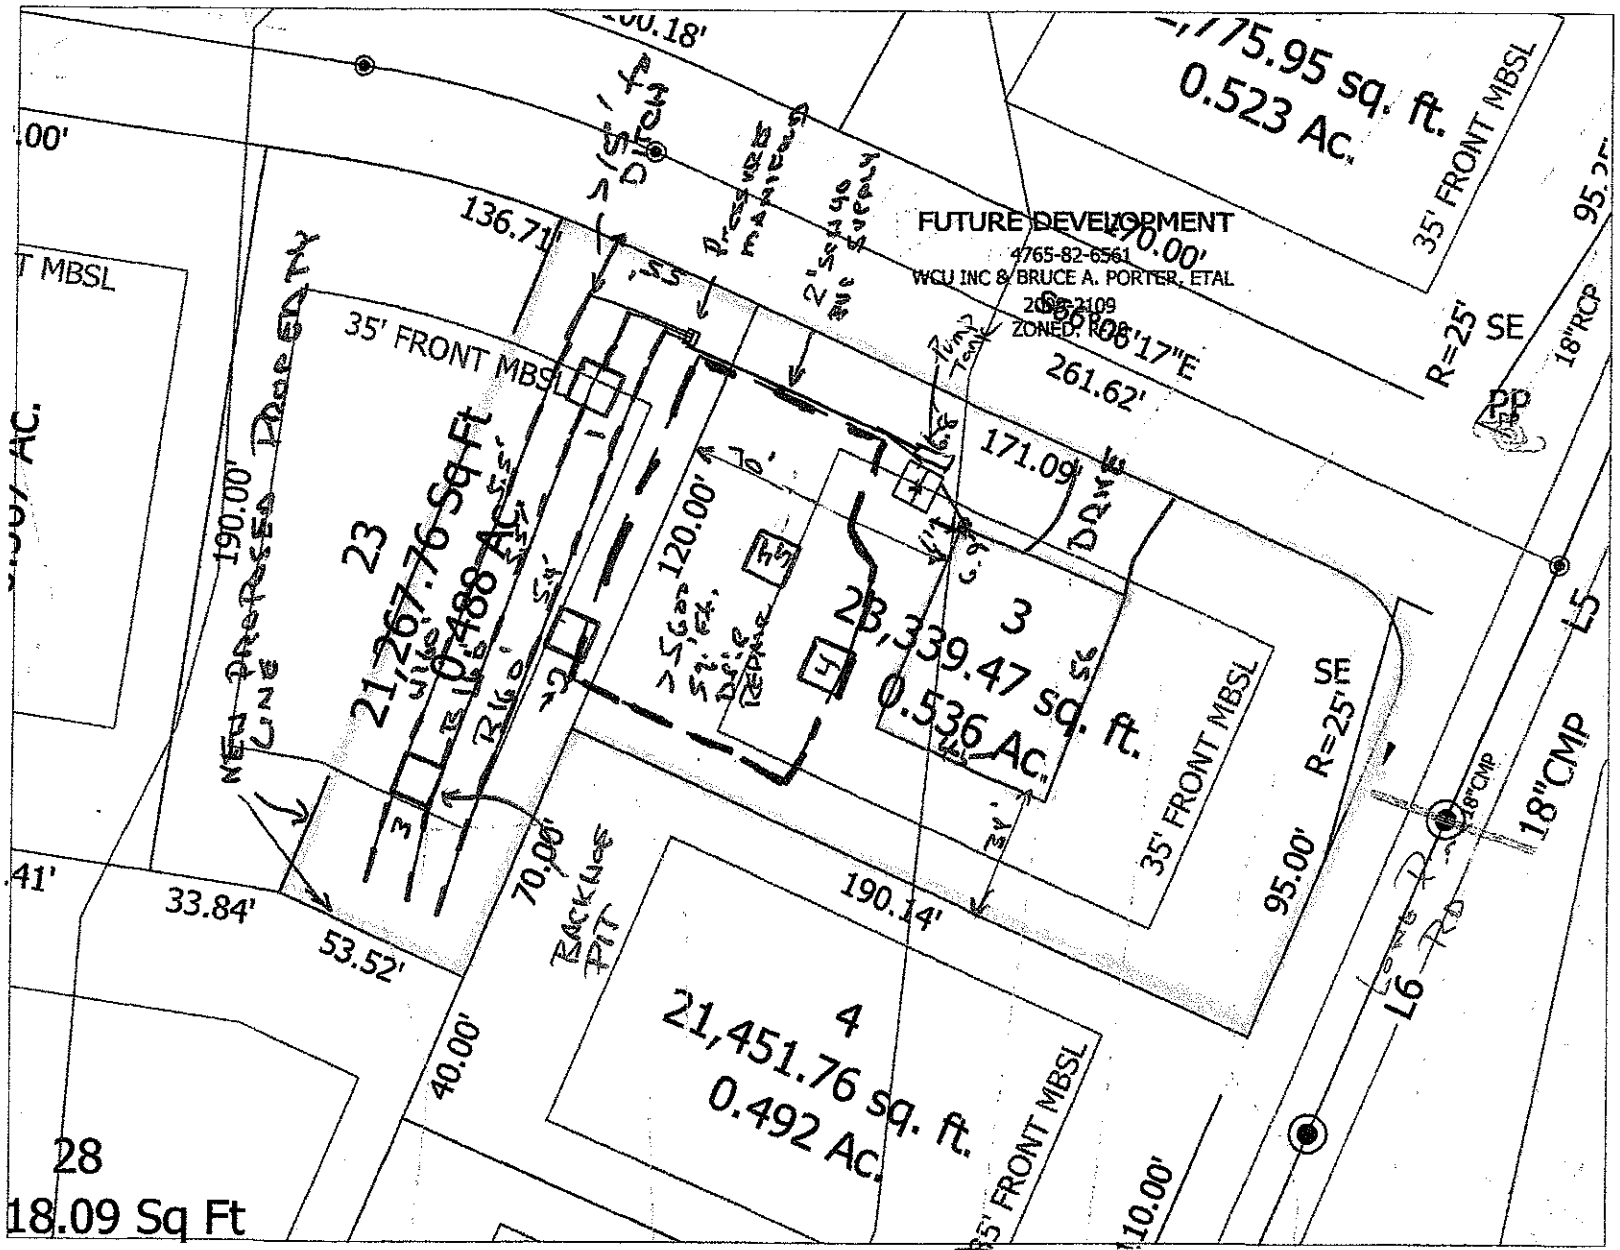

STEVE HART LOT 3 LONE PINE MEADOW
SEPTIC SKETCH 7-8-15 1"=50'

* SITE PLAN MUST ACCOMPANY PERMANENT SOIL CONSULTING WRITTEN REPORT DATED 7-8-15

* BASE MAP FROM B.V. GRANT.