IREDELL COUNTY HEALTH DEPARTMENT

Statesville Office (704) 878-5305 Mooresville Office (704) 660-3625 PERMIT # 208173

IMPROVEMENT PERMIT / AUTHORIZATION TO CONSTRUCT / OPERATION PERMIT / EXISTING SYSTEM

PIN # 4765818474

APPLICANT: Bruce Porter APPLICANT ADDRESS: 2193 Mocksville Hwy

SITE ADDRESS: 220 Lone Pine Rd PHONE: 704-902-3124 ALT. PHONE: N/A

SITE DIRECTIONS: Hwy 64 E TR Lone Pine Rd.


SUBDIVISION: Lone Pine Meadows SECTION: 2 LOT # 2 LOT AREA: 0.523 acres DESIGN FLOW: 360gpd L.T.A.R.: 0.225

Septic Tank	1000 (gal)	STB	160-1000	Date	6-18-15	☑ New System ☐ Repair ☐ Expansion	System Type: I II (III) IV V VI	☑ Residence	No. Bedrooms 3
Pump Tank	(gal)	PT		Date		System Description:	25% Reduction	☐ Business	No. Persons 6
Pump Make		Model		Serial #		Repair System Description:	25% Reduction	☐ Other	No. Employees
# Nitrification Fields	1	# Lines	5	Linear Ft:	400	Maintenance Agreement Required:	☐ YES ☑ NO	☐ Slab	☑ Crawl Space
Trench Width	36"	Max. Trench Bottom Depth	36"	Gravel Depth	N/A	☑ GRAVITY	☐ PRESSURE	☐ Basement w/plumbing	☐ Basement w/o plumbing

Water Supply: ☐ Private ☑ Public ☐ Community

Comments / Conditions: Install a 25% Reduction system on contours with serial distribution.

INITIAL SITE SKETCH

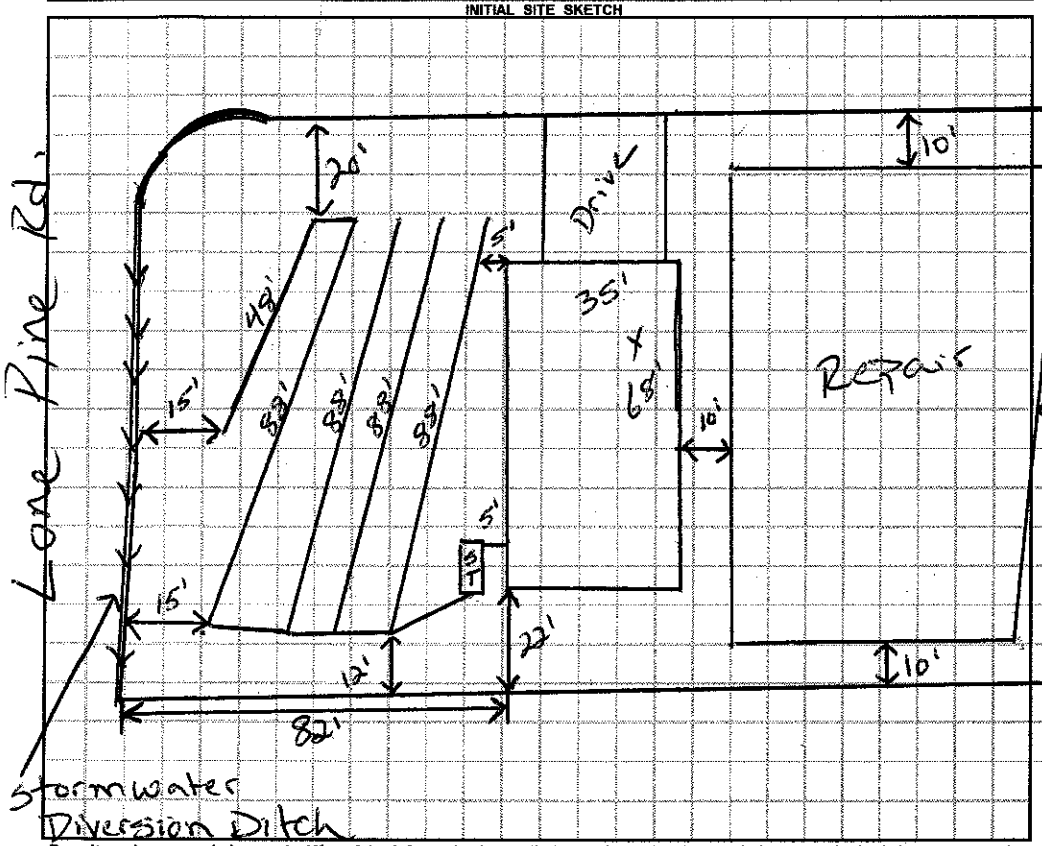

AS BUILT SKETCH

- Red Polyfor filter installed
- 2" PVC ST marker installed
- Quick 4 chambers installed as drawn
- Installed

Permit can be suspended or revoked if any false information is supplied toward securing the permit / any unauthorized changes are made to the site / any unauthorized changes are made in the installation of the system. CONTACT A LOCATOR SERVICE PRIOR TO ANY EXCAVATION

☐ IMPROVEMENT PERMIT with plat valid without expiration. ☑ IMPROVEMENT PERMIT with site plan valid for 60 mos. ☑ AUTHORIZATION TO CONSTRUCT valid for period equal to IMPROVEMENT PERMIT--not to exceed 60 mo.

Owner / Applicant Signature: Bruce Port Date: 2-24-15 Installed by: Cothern & Sons

IMPROVEMENT PERMIT by: Justin Henderson Date: 2-24-15 OPERATION PERMIT by: Justin Henderson Date: 8-19-15

AUTHORIZATION TO CONSTRUCT by: Justin Henderson Date: 2-24-15 Existing System Inspected by: Date:

Health Dept. Copy - WHITE Applicant (Final Approval) - YELLOW Applicant (Conditional Approval) - PINK