IREDELL COUNTY HEALTH DEPARTMENT

Statesville Office (704) 878-5305 Mooresville Office (704) 660-3625 PERMIT # 200381

IMPROVEMENT PERMIT / AUTHORIZATION TO CONSTRUCT / OPERATION PERMIT / EXISTING SYSTEM

PIN # 4765819553

APPLICANT: WCU INC APPLICANT ADDRESS: Po Box 64 Stenhatchee FL

SITE ADDRESS: 214 Lone Pine Rd. PHONE: 704-902-3124 ALT. PHONE: N/A


SITE DIRECTIONS: Hwy 64E TR Lone Pine Rd.

SUBDIVISION: Lon Pine Meadows SECTION: P1 LOT # 1 LOT AREA: 0.61 acres DESIGN FLOW: 360 gpd L.T.A.R.: 0.25

Septic Tank 1000 (gal)	STB 1000-160	Date 12-3-13	☑ New System ☐ Repair ☐ Expansion System Type: I II III IV V VI	☑ Residence	No. Bedrooms 3	Water Supply
Pump Tank (gal)	PT	Date	System Description: 25% Reduction	☐ Business	No. Persons 6 max	☐ Private
Pump Make	Model	Serial #	Repair System Description: 50% Reduction	☐ Other	No. Employees	☑ Public
# Nitrification Fields 1	# Lines 5	Linear Ft: 360	Maintenance Agreement Required: ☐ YES ☑ NO	☐ Slab	☑ Crawl Space	☐ Community
Trench Width 36"	Max. Trench Bottom Depth 36"	Gravel Depth N/A	☑ GRAVITY ☐ PRESSURE	☐ Basement w/plumbing	☐ Basement w/o plumbing	

Comments / Conditions: Install a 25% Reduction system on contour with serial distribution. Water line shall be a minimum of 10' away from all components of septic tank system & repair area.

INITIAL SITE SKETCH

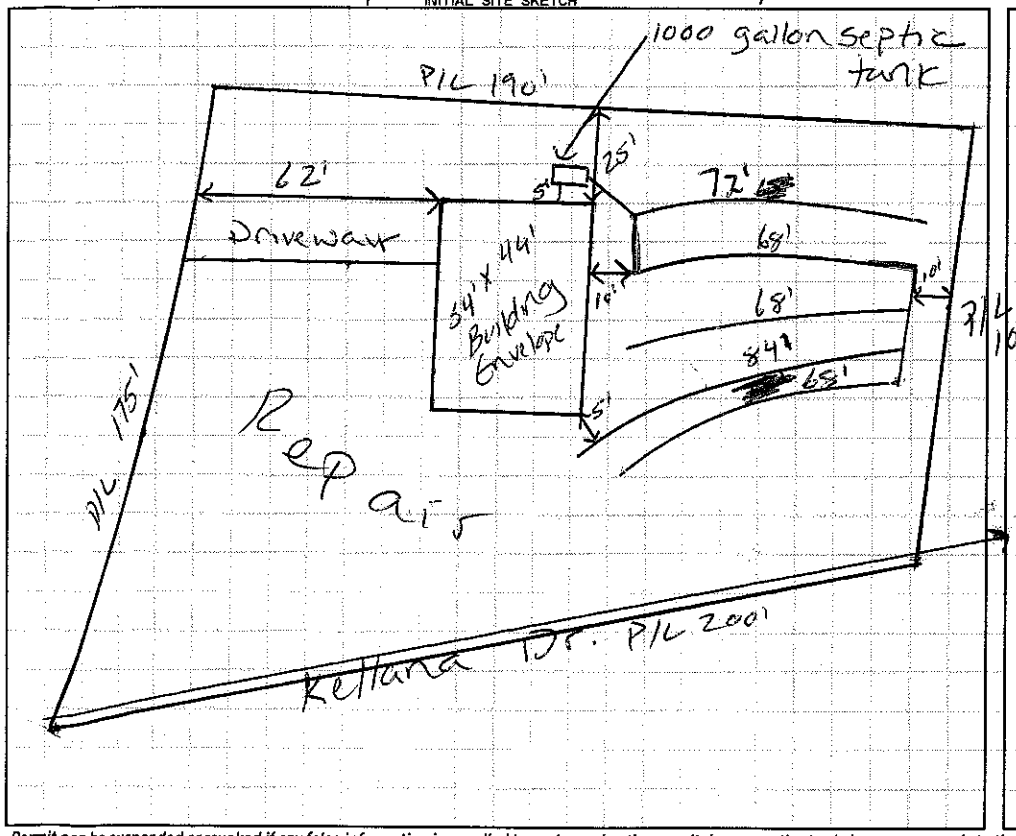

AS BUILT SKETCH

- Red Polylok filter installed
- 2" PVC tank marker installed
- Quick 4 Chambers Installed.
- Installed as drawn

Permit can be suspended or revoked if any false information is supplied toward securing the permit / any unauthorized changes are made to the site / any unauthorized changes are made in the installation of the system. **CONTACT A LOCATOR SERVICE PRIOR TO ANY EXCAVATION**

☐ **IMPROVEMENT PERMIT** *with plat valid without expiration,* ☑ **IMPROVEMENT PERMIT** *with site plan valid for 60 mos.* ☑ **AUTHORIZATION TO CONSTRUCT** *valid for period equal to IMPROVEMENT PERMIT--not to exceed 60 mo.*

Owner / Applicant Signature: Bruce Post Date: 12-16-13 Installed by: Cotheran & Sons

IMPROVEMENT PERMIT by: Justin Henderson Date: 12-17-13 OPERATION PERMIT by: Justin Henderson Date: 2-27-14

AUTHORIZATION TO CONSTRUCT by: Justin Henderson Date: 12-17-13 Existing System Inspected by: Date:

Health Dept. Copy - WHITE Applicant (Final Approval) - YELLOW Applicant (Conditional Approval) - PINK