IREDELL COUNTY HEALTH DEPARTMENT

STATESVILLE 704-878-5305 MOORESVILLE 704-664-5281

IMPROVEMENT PERMIT / AUTHORIZATION TO CONSTRUCT / OPERATION PERMIT / EXISTING SYSTEM INSPECTION

PERMIT# 88550/89281 PIN# 4765 84 0181 DATE 4-17-00

OWNER OR CONTRACTOR Henry Britt PHONE: Business _____ Home 872 9019

ADDRESS 113 Augusta Dr. Statesville, N.C.

LOCATION 64E TL Pecan Tree Dr.

SUBDIVISION _____ BLOCK / SECTION _____ LOT _____ LOT AREA 11.99acres SITE CLASS PS DESIGN FLOW 240 L.T.A.R. .33

Septic Tank: 1000 Gallons: STB 1001 Date 4-3-00
Pump Tank: _____ Gallons: PT _____ Date _____
Pump Make: _____ Model _____ Serial No. _____
Nitrification Field: No Fields 1 Square Feet 720 Linear Feet 240
No Lines 3 Trench Width 36" Max Trench Bottom Depth 36" Gravel Depth 12"

☑ New System ☐ Repair System Type: I II III IV V VI
System Description: Conv. Gravity
Repair System Description: Pump To Conv.
Maintenance Agreement Required: ☐ Yes ☑ No
☑ Slab ☐ Crawl Space ☐ Basement w/plumbing ☐ Basement wo/plumbing


☐ House/Mod. Home No. Bedrooms 2
☐ Mobile Home No. Bathrooms 1
☐ Business No. Employees _____
☑ Other 2 BR Garage Apt.

Water Supply: ☐ Individual ☑ Public ☐ Community


Comments/Conditions:

Comments/Conditions: SEPTIC TANK W/ RISERS AND MARKER INSTALLED USING "ZABEL" FILTER

INITIAL SITE SKETCH

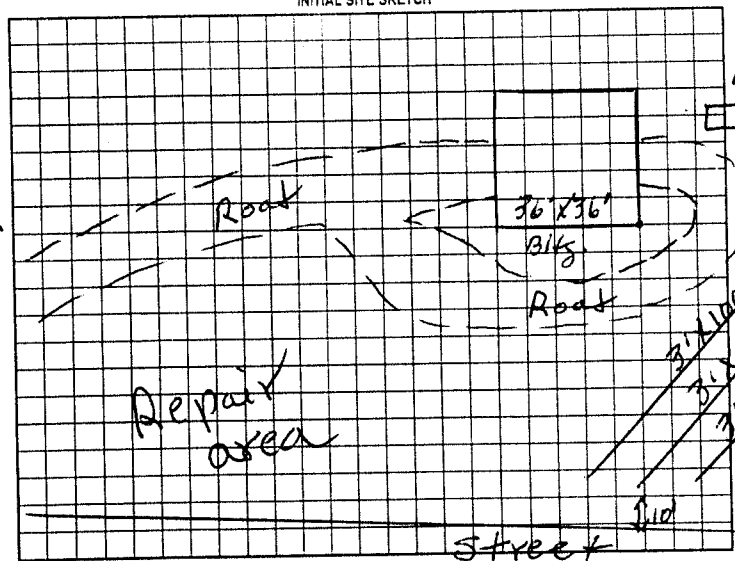

AS BUILT SKETCH

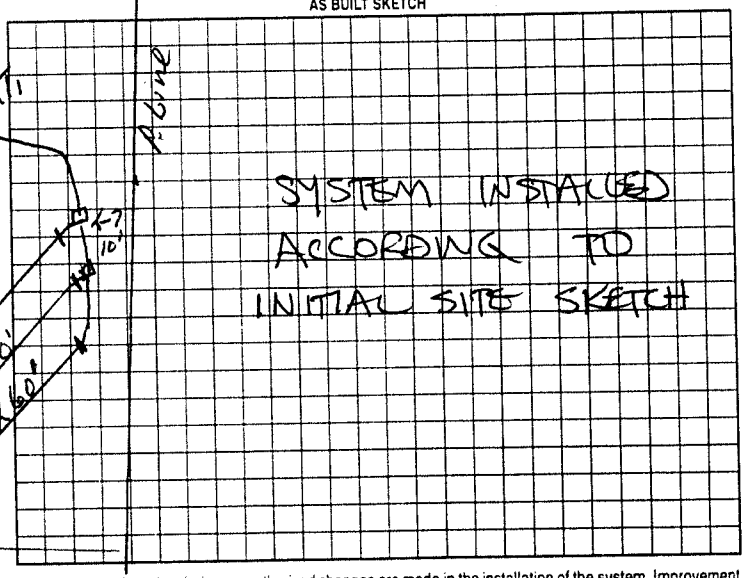

Permit can be suspended or revoked if any false information is supplied toward securing the permit/any unauthorized changes are made to the site/any unauthorized changes are made in the installation of the system. Improvement Permit with plat valid without expiration. Improvement Permit with site plan valid for sixty months. Authorization to Construct is valid for a period equal to that of Improvement Permit – not to exceed sixty months.

Signed: Henry Britt date 4-17-00 Installed by: TRAVIS ENTERPRISES

Improvement Permit by: P. C. Moore date 4-17-00 Operation Permit by: STEVE HEDRICK date 5-18-00

Authorization to Construct by: P. C. Moore date 4-17-00 Existing System Inspection by: _____ date _____

HEALTH DEPT. COPY: WHITE OWNER COPY (FINAL): YELLOW OWNER COPY (INITIAL): PINK