2:00 Dennis

IREDELL COUNTY HEALTH DEPARTMENT

STATESVILLE 704-878-5305 MOORESVILLE 704-664-5281

IMPROVEMENT PERMIT / CERTIFICATE OF COMPLETION / OPERATION PERMIT / EXISTING SYSTEM INSPECTION

PROPERTY DESCRIPTION NO. Joni DATE 10-5-95 TAX MAP NO. Watershed: ☐ Yes ☐ No

OWNER OR CONTRACTOR ~~Joyce~~ Kimmer PHONE: Business Home

ADDRESS Macy Ln.

LOCATION 6H E TR Long Pine Rd TR Macy at end

SUBDIVISION BLOCK / SECTION 3 LOT LOT AREA SITE CLASS DESIGN FLOW 360 L.T.A.R. .3

Septic Tank: 1000 Gallons; STB Date

Pump Tank: 1000 Gallons; PT 17 Date 11-26-96

Pump Make: Hydromatic Model SK50M1 Serial No. 5165402X7

Nitrification Field: No Fields Square Feet Linear Feet

No Lines 4 Trench Width 36 Max Trench Bottom Depth 24

☐ New System ☑ Repair System Type: I, II, III, IV, V, VI

System Description:

Repair System Description: Pump To conv. lines

Maintenance Agreement Required: ☐ Yes ☐ No

Gravel Depth 12" ☑ Slab ☐ Crawl Space ☐ Basement w/plumbing ☐ Basement wo/plumbing

☐ House/Mod. Home No. Bedrooms 3

☐ Mobile Home No. Bathrooms 2

☐ Business No. Employees


☐ Other

Water Supply: ☐ Individual ☐ Community ☑ Public

Comments: Cut off Existing Drain lines And Add New Drain lines as shown

Comments:

INITIAL SITE SKETCH See Attach Drawings for Pump Tank & Pressure manifold.

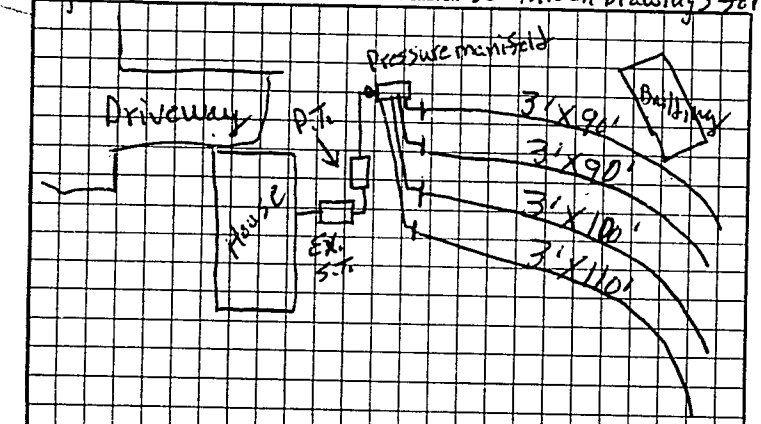

Place Drain

AS BUILT SKETCH

4/21 - Inspected Tank & drain lines MO

Cycled pump for 2ft head

Need to set alarms check floats

4/28 Checked alarm ✓

I understand that this permit can be suspended or revoked if any false information is supplied toward securing the permit/any unauthorized changes are made to the site/any unauthorized changes are made in the installation of the system.

Signed: X Joni D. Kimmer

Improvement Permit by: E.C. Moore date 10-5-95

Authorization to Construct

Existing System Inspection by: E.C. Moore date 10-5-95

Installed by: A-1 Backhoe

Certificate of Completion by: date

Operation Permit by: Mark C Orf date 4-28-97

TO CONST. HEALTH DEPT. COPY WHITE — INSPECTION COPY (FINAL) GREEN — OWNER COPY (FINAL) YELLOW — INSPECTION COPY (INITIAL) PINK — OWNER COPY (INITIAL) GOLD

Authorization to Const. EXPIRES 60 mos. from date of issue