IREDELL COUNTY HEALTH DEPARTMENT

STATESVILLE 704-878-5305 MOORESVILLE 704-664-5281

IMPROVEMENT PERMIT / AUTHORIZATION TO CONSTRUCT / OPERATION PERMIT / EXISTING SYSTEM INSPECTION

PERMIT# 130346 PIN# 4765 92 ~~7594~~ 661 DATE 8/18/05

OWNER OR CONTRACTOR LINDA M TOMLIN PHONE: Business 704 873 3770 Home

ADDRESS 138 LONE PINE RD STATESVILLE, NC 28625

LOCATION 64E ® LONE PINE RD ® LOT NEXT TO 138 LONE PINE RD

SUBDIVISION NA BLOCK / SECTION LOT LOT AREA 2.36 ACRES SITE CLASS. PS DESIGN FLOW 360 GPD L.T.A.R. .25

Septic Tank: 1000 Gallons; STB 825 Date 5-17-06

Pump Tank: Gallons; PT Date

Pump Make: Model Serial No.

Nitrification Field: No Fields 1 Square Feet 480 Linear Feet 240

No Lines 6 Trench Width 24" Max Trench Bottom Depth 30" Gravel Depth NA

☒ New System ☐ Repair System Type: I, II, (III), IV, V, VI

System Description: GRAVITY PPBPS

Repair System Description: PUMP 25% REDUCTION

Maintenance Agreement Required: ☐ Yes ☒ No

☒ Slab ☐ Crawl Space ☐ Basement w/plumbing ☐ Basement wo/plumbing

☒ House/Mod. Home ☐ Mobile Home ☐ Business ☐ Other

No. Bedrooms 3 No. Bathrooms No. Employees


Water Supply: ☐ Individual ☒ Public ☐ Community

Comments:/Conditions: INSTALL ON CONTOUR, MAINTAIN SETBACKS. USE EFFLUENT SPLITTER SUCH AS ZOELLER TRU-FLO. STUB OUT PLUMBING SHALLOW ENOUGH TO MAINTAIN 30" TRENCH BOTTOMS. DO NOT PAVE OVER SEPTIC LINES.

Comments:/Conditions: Blue-Tuf-Tite filter no risers no ST marker

INITIAL SITE SKETCH SCALE: 1" = 50'

AS BUILT SKETCH

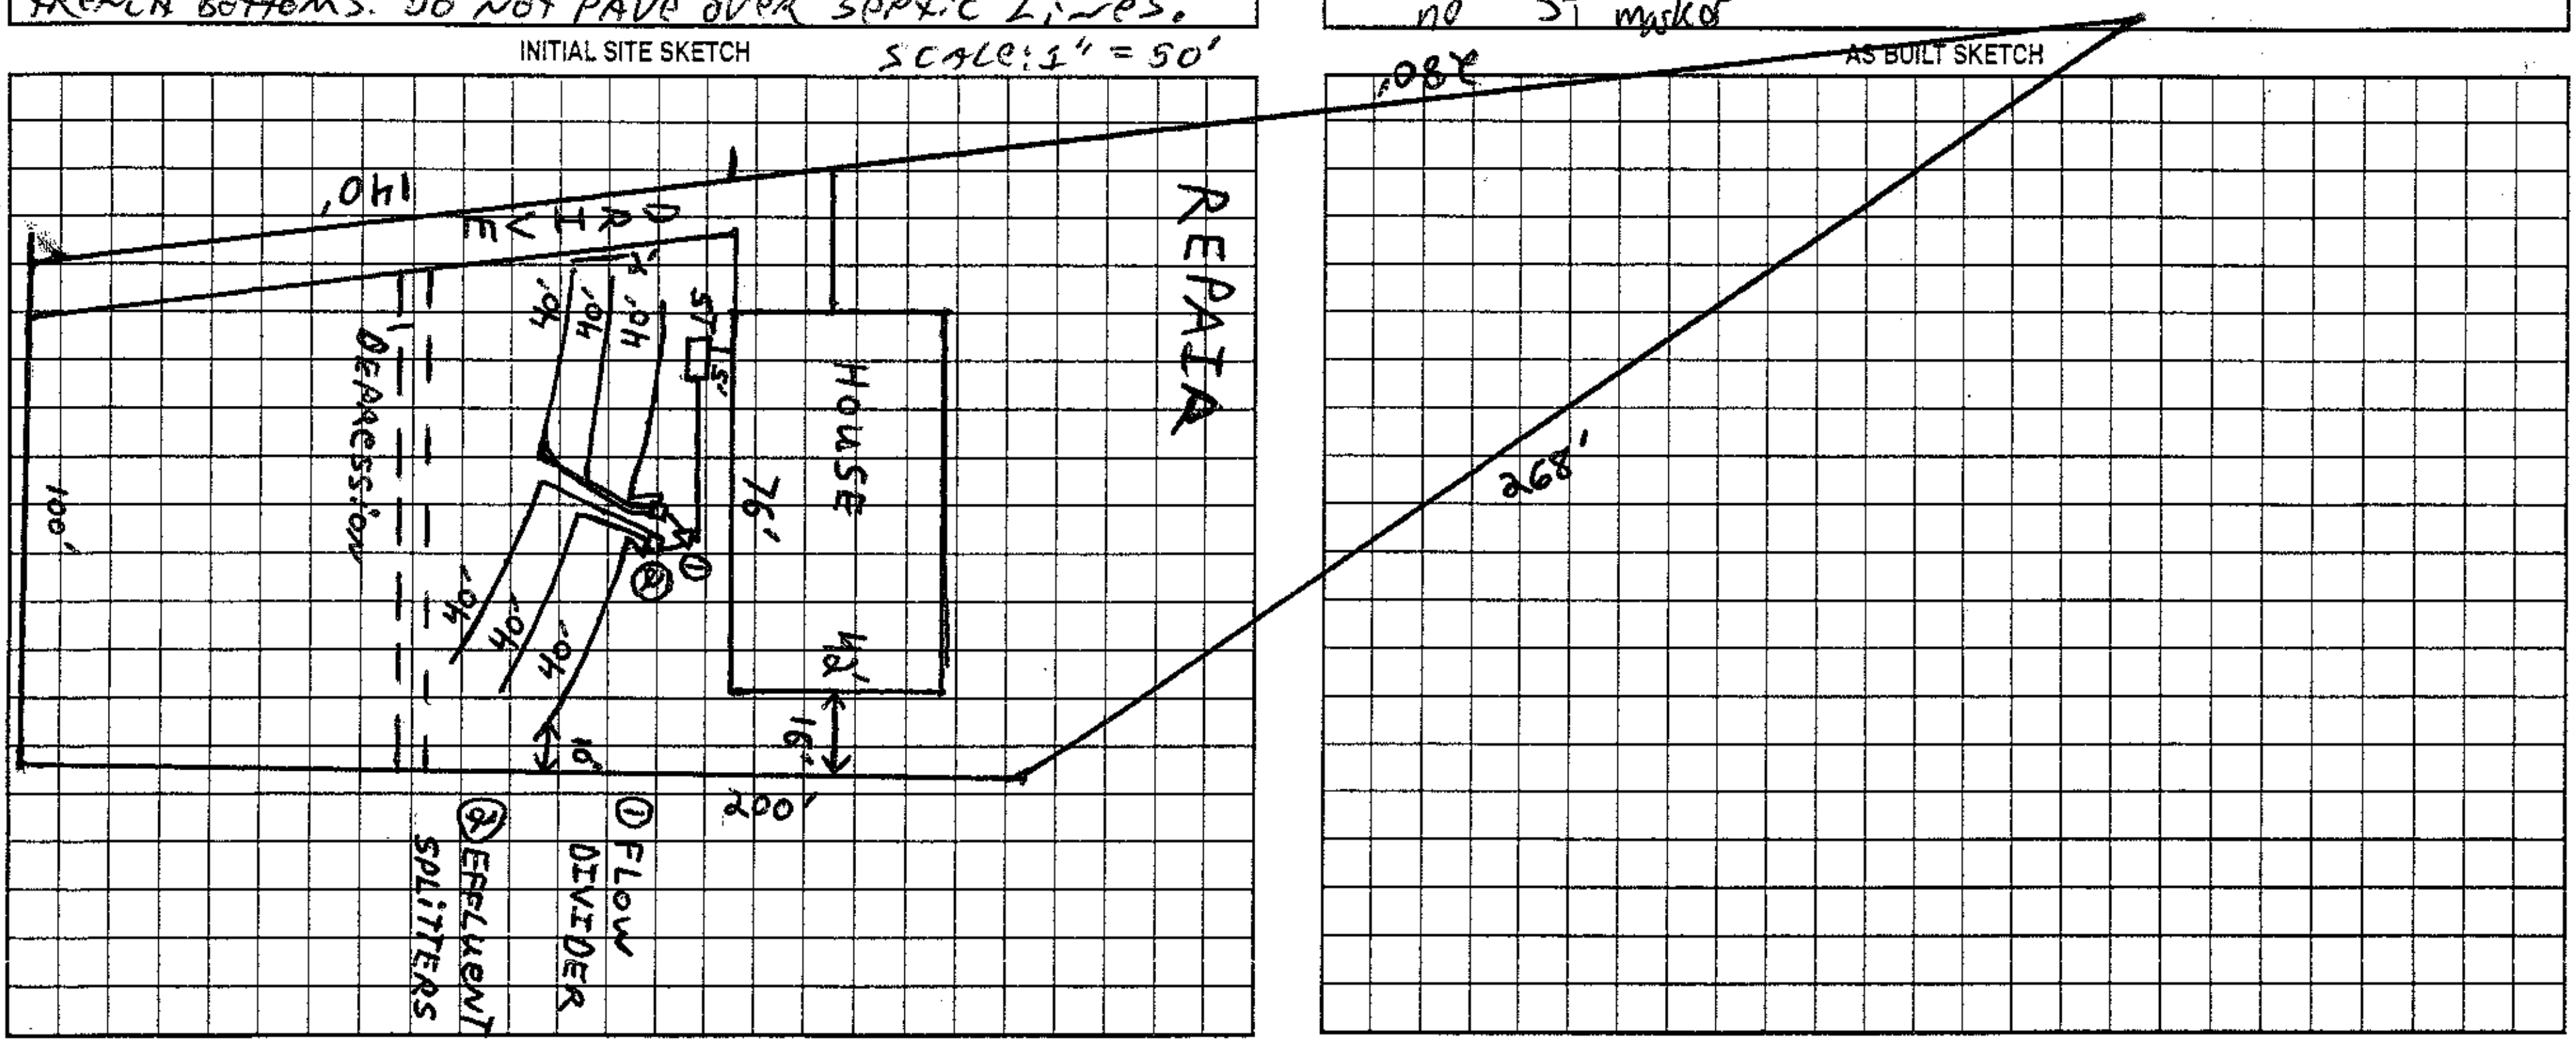

Permit can be suspended or revoked if any false information is supplied toward securing the permit/any unauthorized changes are made to the site/any unauthorized changes are made in the installation of the system. Improvement Permit with plat valid without expiration. Improvement Permit with site plan valid for sixty months. Authorization to Construct is valid for a period equal to that of Improvement Permit – not to exceed sixty months.

Signed: [signature] date 8/18/05 Installed by: Rowan Septic

Improvement Permit by: [signature] date 8/18/05 Operation Permit by: [signature] date 7-12-06

Authorization to Construct by: [signature] date 8/18/05 Existing System Inspection by: date

HEALTH DEPT. COPY: WHITE OWNER COPY (FINAL): YELLOW OWNER COPY (INITIAL): PINK