IREDELL COUNTY HEALTH DEPARTMENT

STATESVILLE 704-878-5305 MOORESVILLE 704-664-5281

IMPROVEMENT PERMIT / AUTHORIZATION TO CONSTRUCT / OPERATION PERMIT / EXISTING SYSTEM INSPECTION

PERMIT# 093773 PIN# 4765 93 7795 DATE 02/09/01

OWNER OR CONTRACTOR THE OWEN CO PHONE: Business 876-8226 Home

ADDRESS 177 RENNAISSANCE PL STATESVILLE NC 28625

LOCATION 646, AT CORNER OF TRIPLE OAKS

SUBDIVISION Triple OAKS BLOCK / SECTION LOT 1 LOT AREA .50 SITE CLASS PS DESIGN FLOW 360 L.T.A.R. 1.3

Septic Tank: 1600 Gallons, STB 825 Date 4-17-01
Pump Tank: Gallons, PT Date
Pump Make: Model Serial No.
Nitrification Field: No Fields 1 Square Feet EB=1200 Linear Feet 300'
No Lines 5 Trench Width 36" Max Trench Bottom Depth 36"

☐ New System ☐ Repair System Type: I. II. (III) IV. V. VI
System Description: ERAU 25% REDUCTION
Repair System Description: PUMP PANEL
Maintenance Agreement Required: ☐ Yes ☒ No
Gravel Depth N/A ☐ Slab ☒ Crawl Space ☐ Basement w/plumbing ☐ Basement wo/plumbing


☒ House/Mod. Home No. Bedrooms 3
☐ Mobile Home No. Bathrooms 2
☐ Business No. Employees
☐ Other

Water Supply: ☐ Individual ☒ Public ☐ Community

Comments/Conditions: ① KEEP SYSTEM 10' off property lines & 5' off house. TANK PLACENT IS CRITICAL ② KEEP FRENCH DRAIN 10' ABOVE SYSTEM & 15' to the side of system. ③ INSTALL ON CONTOUR ④ KEEP

Comments/Conditions: ⑤ H2O LINE 10' AWAY FROM SYSTEM ⑥ THIS LOT HAS AN ABANDONED OLD SYSTEM ON IT

INITIAL SITE SKETCH

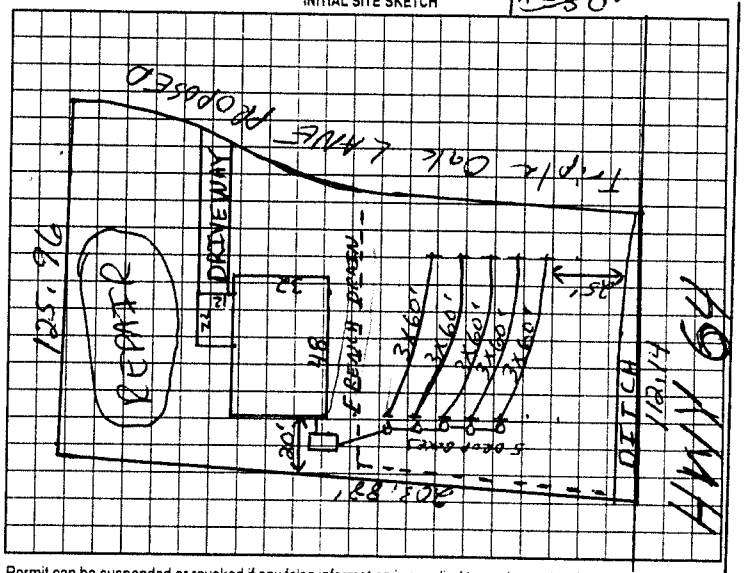

AS BUILT SKETCH

INSTALLED AS SHOWN WITH PUMP & FILTER

Permit can be suspended or revoked if any false information is supplied toward securing the permit/any unauthorized changes are made to the site/any unauthorized changes are made in the installation of the system. Improvement Permit with plat valid without expiration. Improvement Permit with site plan valid for sixty months. Authorization to Construct is valid for a period equal to that of Improvement Permit – not to exceed sixty months.

Signed: date

Improvement Permit by: RSE date 02/09/01

Authorization to Construct by: RSE date 02/09/01

Installed by: ROWAN SEPTIC

Operation Permit by: RSE date 6-18-01

Existing System Inspection by: date

HEALTH DEPT COPY WHITE OWNER COPY (FINAL) YELLOW OWNER COPY (INITIAL) PINK