CI

IREDELL COUNTY HEALTH DEPARTMENT

STATESVILLE 704-878-5305 MOORESVILLE 704-664-5281

IMPROVEMENT PERMIT / AUTHORIZATION TO CONSTRUCT / OPERATION PERMIT / EXISTING SYSTEM INSPECTION

PERMIT# 101336 PIN# 4765-93-7795.2 DATE 7/24/01

OWNER OR CONTRACTOR A H INC PHONE: Business 704-885-2300 Home

ADDRESS 450 AUCTION DR SALISBURY, NC 28147

LOCATION HWY 64 E, (6) TRIPLE OAK 2nd LOT ON LEFT

SUBDIVISION TRIPLE OAKS BLOCK / SECTION LOT 2 LOT AREA .4591 AC SITE CLASS PS DESIGN FLOW 360 L.T.A.R. .3

Septic Tank: 1000 Gallons; STB 825 Date 5-21-01
Pump Tank: Gallons; P.T. Date
Pump Make: Model Serial No.
Nitrification Field: No Fields 1 Square Feet EQ=1200' Linear Feet 300'
No. Lines 3 Trench Width 36" Max Trench Bottom Depth (36") Gravel Depth N/A

[X] New System [ ] Repair System Type: I, II, (III), IV, V, VI
System Description: GRAV 25% RED
Repair System Description: LP PANEL
Maintenance Agreement Required: [ ] Yes [X] No

[X] House/Mod. Home No. Bedrooms 3
[ ] Mobile Home No. Bathrooms 2
[ ] Business No. Employees
[ ] Other


Water Supply: [ ] Individual [X] Public [ ] Community

[ ] Slab [X] Crawl Space [ ] Basement w/plumbing [ ] Basement wo/plumbing

Comments/Conditions: (1) INSTALL DRAIN LINES 36" DEEP & FRENCH DRAIN 48" DEEP (2) USE SUMP PUMP & CATCH BASIN (FRENCH DRAIN) & EXIT INTO DITCH (3) MAINTAIN SETBACKS (4) INSTALL LINES ON CONTOUR (5) USE 50 CHAMBERS OR 30 HOS SECTIONS

Comments/Conditions: NEEDS SUMP PUMP CHECKED CHECKED 9-11-01 NEEDS TO HARD LINE TO RAN OFF GENERATOR

INITIAL SITE SKETCH 1" = 50'

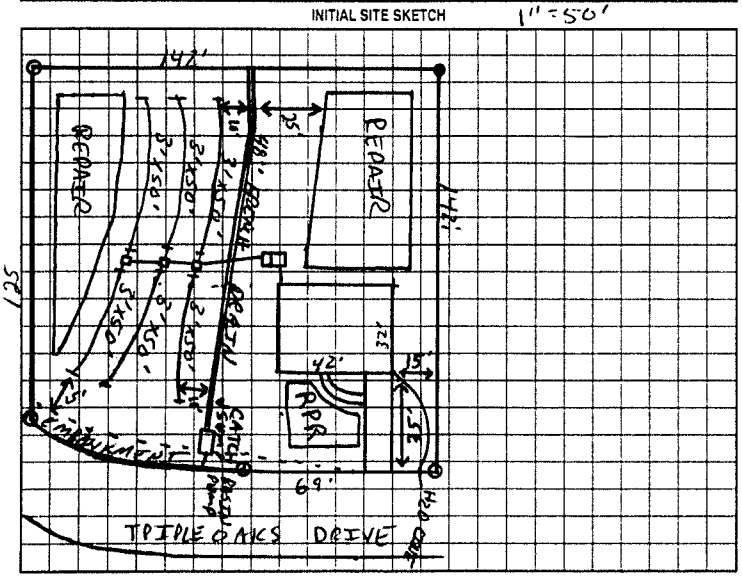

AS BUILT SKETCH

1ST LINE = 17
2nd LINE = 16
3rd LINE = 17
(CHAMBERS)

Permit can be suspended or revoked if any false information is supplied toward securing the permit/any unauthorized changes are made to the site/any unauthorized changes are made in the installation of the system. Improvement Permit with plat valid without expiration. Improvement Permit with site plan valid for sixty months. Authorization to Construct is valid for a period equal to that of Improvement Permit – not to exceed sixty months.

Signed: date

Installed by: ROWAN SEPTIC

Improvement Permit by: RS date 7-24-01

Operation Permit by: RS date 9-11-01

Authorization to Construct by: RS date 7-24-01

Existing System Inspection by: date

HEALTH DEPT COPY: WHITE OWNER COPY (FINAL): YELLOW OWNER COPY (INITIAL): PINK