IREDELL COUNTY HEALTH DEPARTMENT

STATESVILLE 704-878-5305 (I) MOORESVILLE 704-664-5281

IMPROVEMENT PERMIT / AUTHORIZATION TO CONSTRUCT / OPERATION PERMIT / EXISTING SYSTEM INSPECTION

PERMIT# 101339 PIN# 4765-93-~~7795.9~~ 8563

OWNER OR CONTRACTOR AH INC DATE 2-21-02

ADDRESS 450 AUCTION DR SALISBURY NC 28147 PHONE: Business 704-885-2300 Home

LOCATION HWY 64E, (C) TRIPLE OAKS, FIRST LOT ON RT

SUBDIVISION TRIPLE OAKS BLOCK / SECTION LOT 9 LOT AREA SITE CLASS PS DESIGN FLOW 240 L.T.A.R. 12

Septic Tank: 1000 Gallons: STB 825 Date 1-3-02
Pump Tank: 1000 Gallons; PT 302 Date 2-1-02
Pump Make: ZOELLER Model 137 Serial No. 37-0602-0102
Nitrification Field: No Fields 1 Square Feet EQ=1200' Linear Feet 200'
No Lines 6 Trench Width 24" Max Trench Bottom Depth (42") Gravel Depth N/A

[X] New System [ ] Repair System Type: I, II, III, (IV), V, VI
System Description: LP PANEL
Repair System Description: LP PANEL
Maintenance Agreement Required: [X] Yes [ ] No


[X] House/Mod. Home No. Bedrooms 2
[ ] Mobile Home No. Bathrooms 1
[ ] Business No. Employees
[ ] Other
[X] Slab [ ] Crawl Space [ ] Basement w/plumbing [ ] Basement wo/plumbing

Water Supply: [ ] Individual [X] Public [ ] Community

Comments/Conditions: (1) INSTALL FRENCH DRAIN 54" DEEP (2) TIE FD INTO NEIGHBORS (3) INSTALL 46 PANELS, FED BY LOW PRESSURE ON CONTOURS (4) MUST HAVE SIGNED MAINTENANCE AGREEMENT B4 OP IS ISSUED (5) MAINTAIN SETBACKS (6) LINE & RAISE 111=40'

Comments/Conditions: TRENCH WALLS VERY GOOD! (7) DIVERT SURFACE H2O DOWN PROPERTY LINE (8) CALL PRIOR TO INSTALLATION FOR PUMP INFO (9) IF SYSTEM is installed B-U HOUSE BUILT, PUT UP FENCE TO ELIMINATE VEHICULAR TRAFFIC, (10) HOUSE & SYSTEM IS COMPLETELY FLAGGED

INITIAL SITE SKETCH,

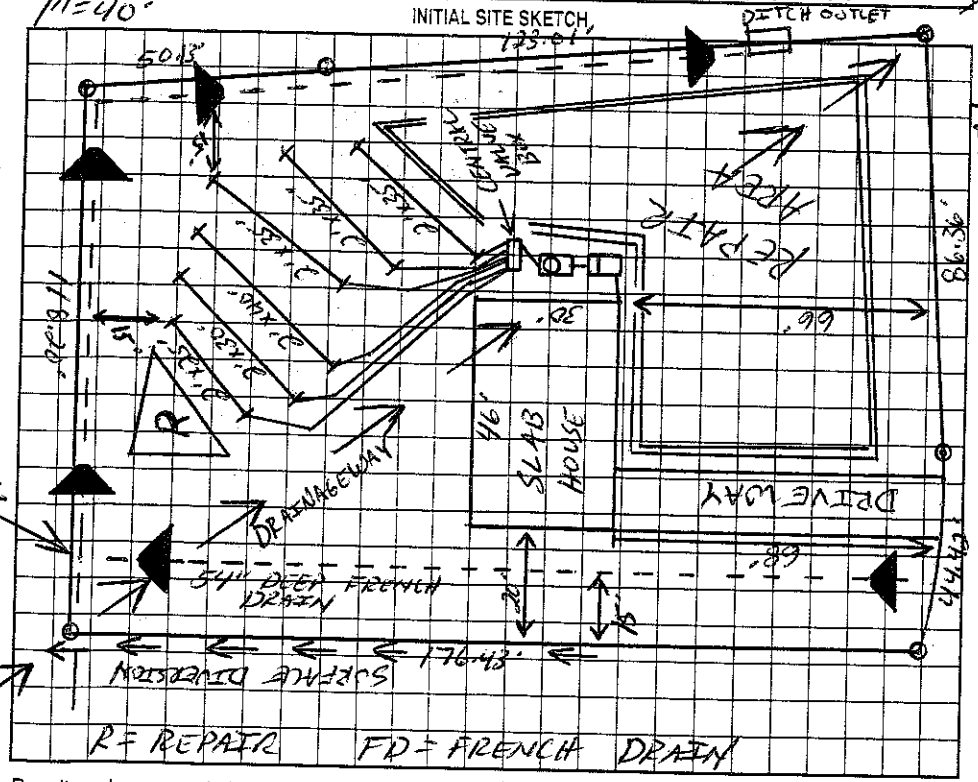

AS BUILT SKETCH OUT.

POLY LOK FILTER & MARKER
(4) VALVE BOX MOVED TO TOP OF FIELD TO ELIMINATE BLEED BACK ON LAST LINE,

SET PRESSURE & V LINES
V'D ELECTRICAL NEEDS MAINTENANCE CONTRACT

EXCESSIVE POSITIVE DRAINAGE AROUND HOUSE, FIX WHEN B-U SIGNED OFF ON OP. TOOK BRADY OUT AT SITE WHEN COMPLETED HOUSE SITE HAS BEEN CUT AND ALTERED FROM TIME OF INITIAL L/O, ALSO NEEDS SURFACE H2O DIVERTED DOWN P/L.

EVERYTHING V'D & FIXED, GOT CONTRACT, GOOD TO GO, LC 06-11-02

Permit can be suspended or revoked if any false information is supplied toward securing the permit/any unauthorized changes are made to the site/any unauthorized changes are made in the installation of the system. Improvement Permit with plat valid without expiration. Improvement Permit with site plan valid for sixty months. Authorization to Construct is valid for a period equal to that of Improvement Permit – not to exceed sixty months.

Signed: _____ date _____

Improvement Permit by: Jim Cook RS date 2-21-02

Authorization to Construct by: Jim Cook RS date 2-21-02

Installed by: ROWAN SEPTIC

Operation Permit by: Jim Cook RS date 06-11-02

Existing System Inspection by: _____ date _____

HEALTH DEPT. COPY: WHITE OWNER COPY (FINAL): YELLOW OWNER COPY (INITIAL): PINK