# IREDELL COUNTY HEALTH DEPARTMENT

STATESVILLE 704-878-5305 MOORESVILLE 704-664-5281

## IMPROVEMENT PERMIT / AUTHORIZATION TO CONSTRUCT / OPERATION PERMIT / EXISTING SYSTEM INSPECTION

PERMIT# 101339 PIN# 4765-93-~~7795-9~~ 8563 DATE 2-21-02

OWNER OR CONTRACTOR AH INC PHONE: Business 704-885-2300 Home

ADDRESS 450 AUCTION DR SALISBURY NC 28147

LOCATION HWY 64 E, (L) TRIPLE OAKS, FIRST LOT ON RT

SUBDIVISION TRIPLE OAKS BLOCK / SECTION LOT 9 LOT AREA SITE CLASS. PS DESIGN FLOW 240 L.T.A.R. .2

Septic Tank: 1000 Gallons; STB 825 Date 1-3-02
Pump Tank: 1000 Gallons; PT 302 Date 2-1-02
Pump Make: ZOELLER Model 137 Serial No. 37-0002-0102
Nitrification Field: No Fields 1 Square Feet EQ=1200 Linear Feet 200
No Lines 6 Trench Width 24" Max Trench Bottom Depth 42" Gravel Depth N/A

☒ New System ☐ Repair System Type: I, II, III, (IV), V, VI
System Description: LP PANEL
Repair System Description: LP PANEL
Maintenance Agreement Required: ☒ Yes ☐ No
☒ Slab ☐ Crawl Space ☐ Basement w/plumbing ☐ Basement wo/plumbing

☒ House/Mod. Home ☐ Mobile Home ☐ Business ☐ Other
No. Bedrooms 2 No. Bathrooms 1 No. Employees


Water Supply: ☐ Individual ☒ Public ☐ Community

Comments:/Conditions: (1) INSTALL FRENCH DRAIN 54" DEEP (2) TIE FD INTO NEIGHBORS (3) INSTALL 46 PANELS, FED BY LOW PRESSURE ON CONTOURS (4) MUST HAVE SIGNED MAINTENANCE AGREEMENT B4 OP IS ISSUED (5) MAINTAIN SETBACKS (6) LIME + RAKE

Comments:/Conditions: TRENCH WALLS VERY GOOD! (7) DIVERT SURFACE H2O DOWN PROPERTY LINE (8) CALL PRIOR TO INSTALLATION FOR PUMP INFO (9) IF SYSTEM is installed B4 HOUSE BUILT, PUT UP FENCE TO ELIMINATE VEHICULAR TRAFFIC (10) HOUSE + SYSTEM IS COMPLETELY FLAGGED OUT.

1" = 40'

INITIAL SITE SKETCH

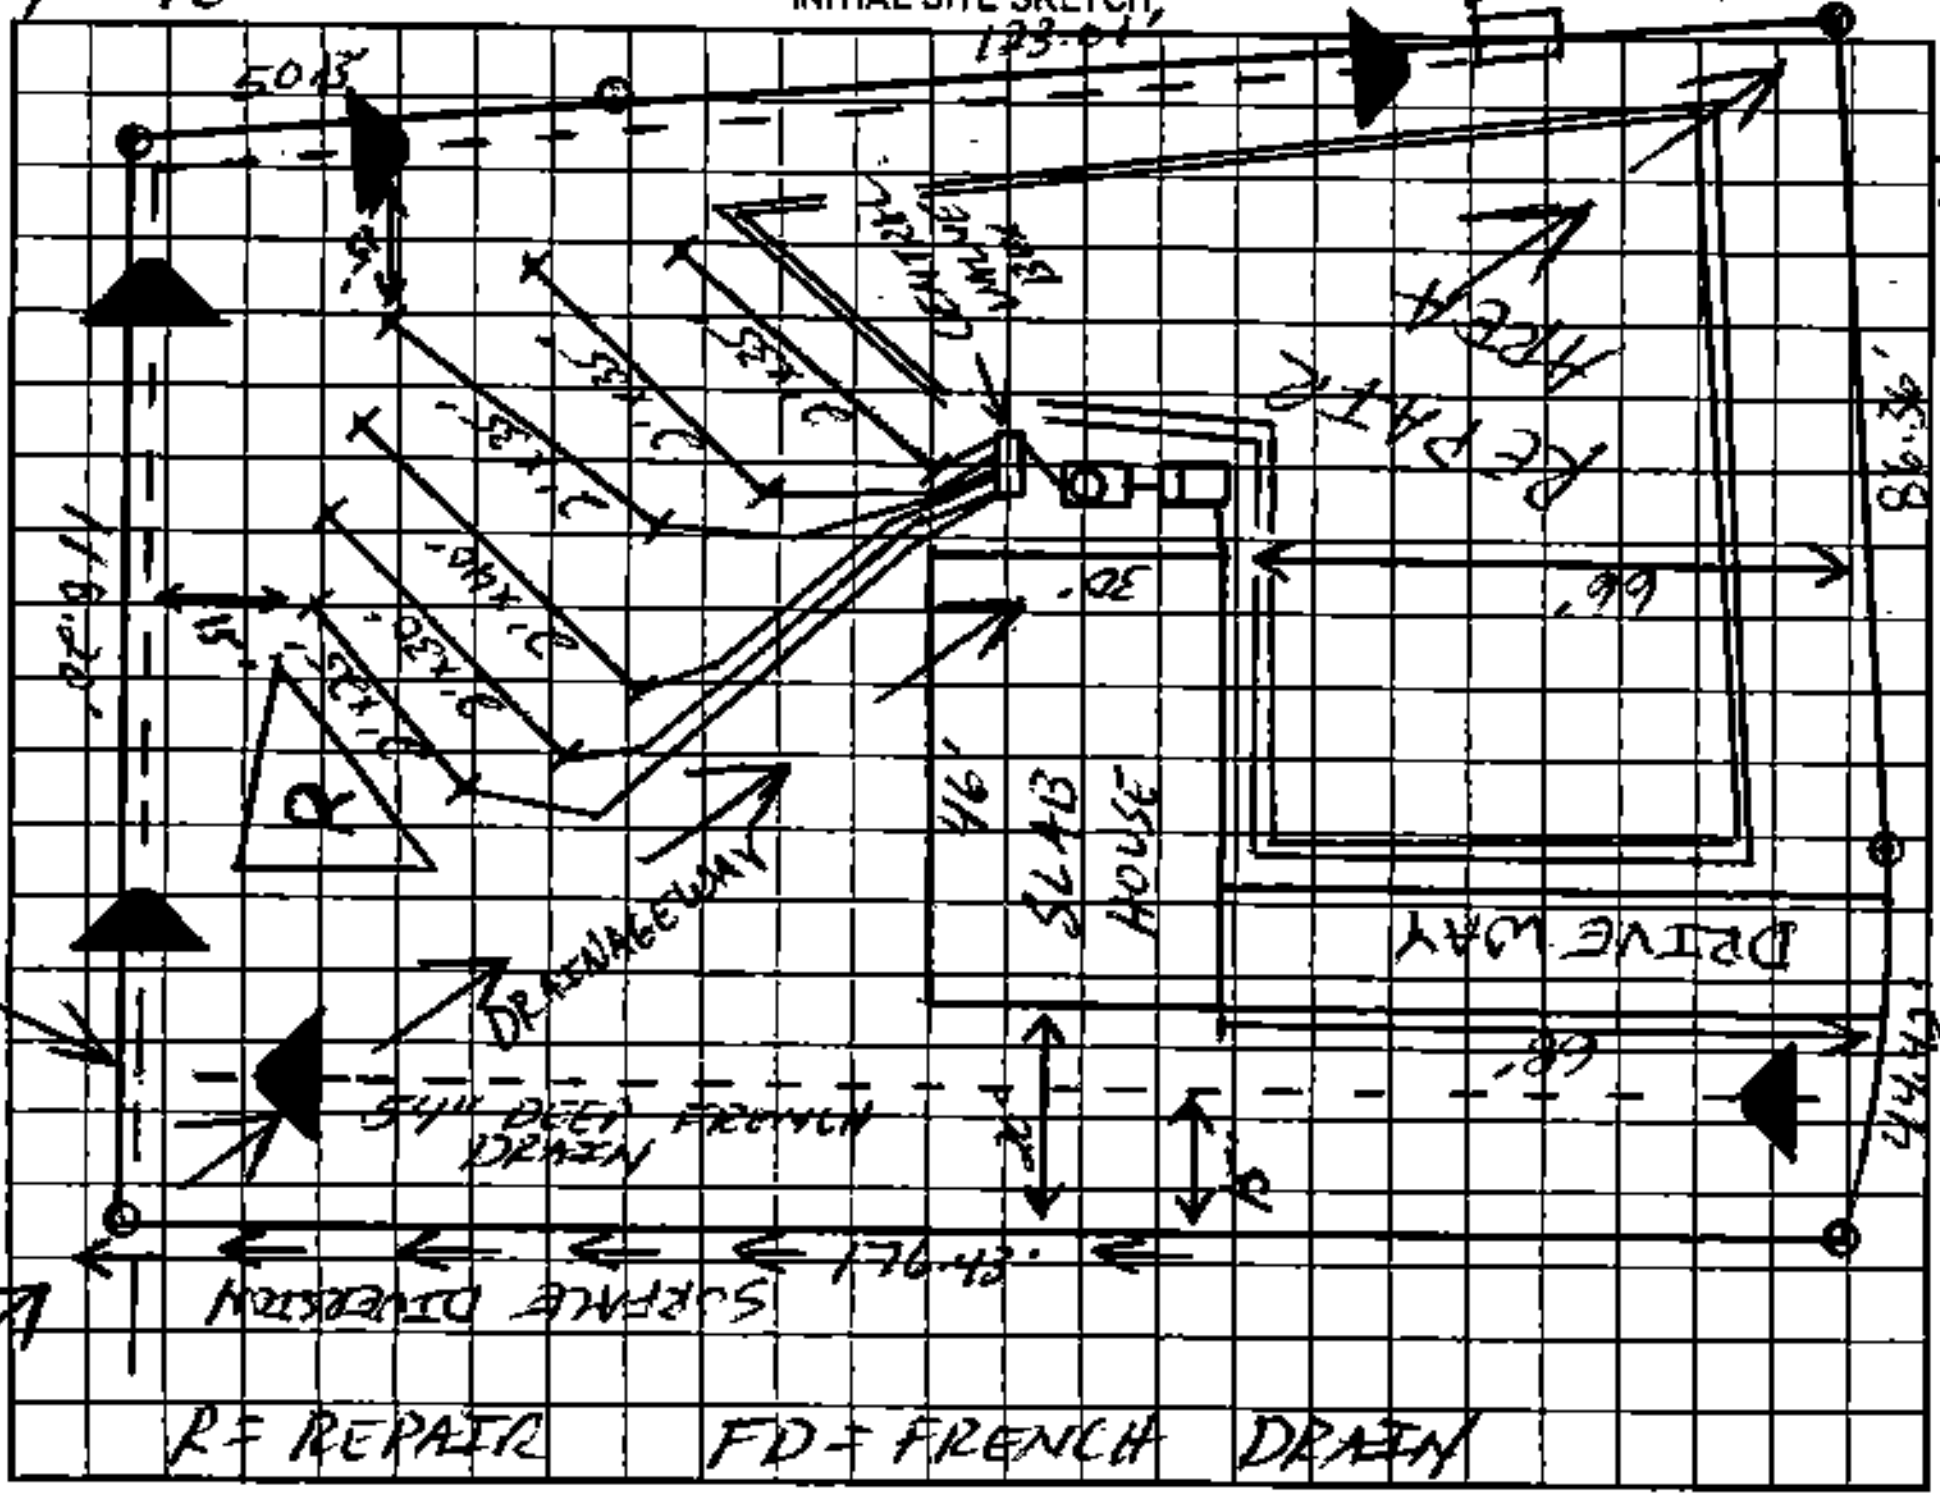


AS BUILT SKETCH

POLY LOK FILTER + MARKER
(8) VALVE BOX MOVED TO TOP OF FIELD TO ELIMINATE BLEED BACK ON LAST LINE

SET PRESSURE ✓ LINES
✓'D ELECTRICAL NEEDS MAINTENANCE CONTRACT

EXCESSIVE POSITIVE DRAINAGE AROUND HOUSE, FIX + FILL B-4 SIGNING OFF ON OP. TOOK BRADY OUT AT SITE + WE CONCLUDED HOUSE SITE HAD BEEN CUT AND ALTERED FROM TIME OF INITIAL L/O. ALSO NEEDS SURFACE H2O DIVERTED DOWN P/L.

EVERYTHING ✓'D + FIXED, GOT CONTRACT, GOOD TO GO, LC 06-11-02

Permit can be suspended or revoked if any false information is supplied toward securing the permit/any unauthorized changes are made to the site/any unauthorized changes are made in the installation of the system. Improvement Permit with plat valid without expiration. Improvement Permit with site plan valid for sixty months. Authorization to Construct is valid for a period equal to that of Improvement Permit – not to exceed sixty months.

Signed: [signature] date

Improvement Permit by: [signature] RS date 2-21-02

Authorization to Construct by: [signature] RS date 2-21-02

Installed by: ROWAN SEPTIC

Operation Permit by: [signature] RS date 06-11-02

Existing System Inspection by: date

HEALTH DEPT. COPY: WHITE OWNER COPY (FINAL): YELLOW OWNER COPY (INITIAL): PINK