CI

IREDELL COUNTY HEALTH DEPARTMENT

STATESVILLE 704-878-5305 MOORESVILLE 704-664-5281

IMPROVEMENT PERMIT / AUTHORIZATION TO CONSTRUCT / OPERATION PERMIT / EXISTING SYSTEM INSPECTION

PERMIT# 101338 PIN# 4765-93-7795.B

OWNER OR CONTRACTOR AH INC. PHONE: Business 704-855-2300 Home DATE 10-12-01

ADDRESS 450 AUCTION DR SALISBURY NC 28147

LOCATION HWY 64 E (L) TRIPLE OAKS, 2nd LOT ON RT

SUBDIVISION TRIPLE OAKS BLOCK / SECTION LOT 8 LOT AREA .4592 AC SITE CLASS PS DESIGN FLOW 360 L.T.A.R. 1.2

Septic Tank: 1000 Gallons: STB 825 Date 9-24-01
Pump Tank: Gallons: PT Date
Pump Make: Model Serial No.
Nitrification Field: No Fields 1 Square Feet EA=1800' Linear Feet 300'
No Lines 6x50' Trench Width 24" Max Trench Bottom Depth (42") Gravel Depth N/A

[X] New System [ ] Repair System Type: I, II, (III), IV, V, VI
System Description: TRAY PANEL
Repair System Description: LP PANEL
Maintenance Agreement Required: [ ] Yes [X] No

[X] House/Mod. Home No. Bedrooms 3
[ ] Mobile Home No. Bathrooms 2
[ ] Business No. Employees
[ ] Other


[X] Slab [ ] Crawl Space [ ] Basement w/plumbing [ ] Basement wo/plumbing

Water Supply: [ ] Individual [X] Public [ ] Community


Comments/Conditions: (1) INSTALL PANELS 42" DEEP & TRENCH DRAIN 54" DEEP (2) USE FLOW DIVIDER TEE & 2 DIST BOX'S WITH SPEED LEVELERS (3) MAINTAIN SETBACKS (4) INSTALL LEVEL ON CONTOURS (5) USE 69 PANELS TO EQUAL 300'

Comments/Conditions (6) MAINTAIN SETBACKS (7) LIME & RAKE THE TRENCH WALLS POLYLOK FILTER & MARKER INSTALLED AS SHOWN

INITIAL SITE SKETCH 1" = 40'

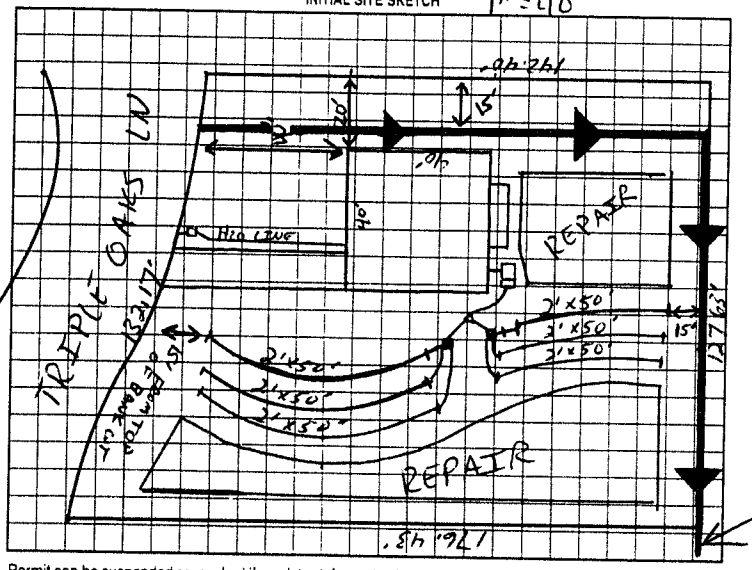

AS BUILT SKETCH

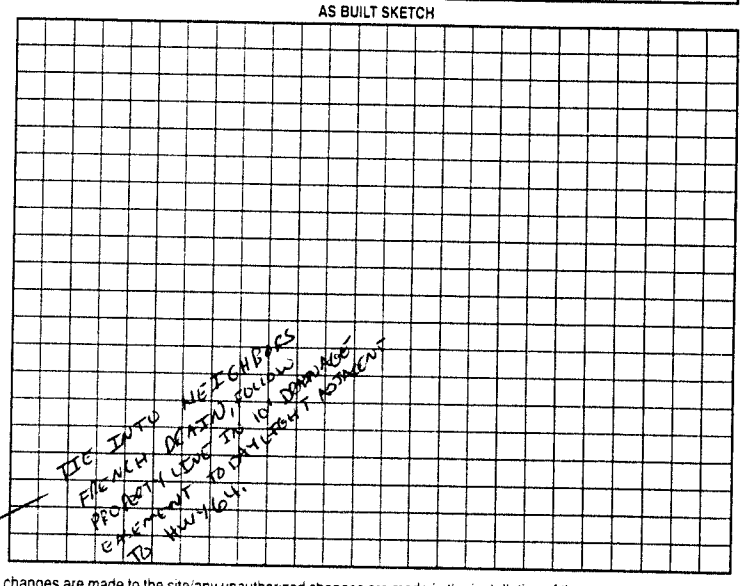

Permit can be suspended or revoked if any false information is supplied toward securing the permit/any unauthorized changes are made to the site/any unauthorized changes are made in the installation of the system. Improvement Permit with plat valid without expiration. Improvement Permit with site plan valid for sixty months. Authorization to Construct is valid for a period equal to that of Improvement Permit – not to exceed sixty months.

Signed: date 10/15/01 Installed by: ROWAN SEPTIC

Improvement Permit by: RS date 10-12-01 Operation Permit by: RS date 11-13-01

Authorization to Construct by: RS date 10-12-01 Existing System Inspection by: date

HEALTH DEPT. COPY WHITE OWNER COPY (FINAL) YELLOW OWNER COPY (INITIAL) PINK