IREDELL COUNTY HEALTH DEPARTMENT

STATESVILLE 704-878-5305 MOORESVILLE 704-664-5281

IMPROVEMENT PERMIT / AUTHORIZATION TO CONSTRUCT / OPERATION PERMIT / EXISTING SYSTEM INSPECTION

PERMIT# REPAIR PIN# DATE 09-16-02

OWNER OR CONTRACTOR JOHN MOOREFIELD PHONE: Business 880-6603 Home 704-873-7885

ADDRESS 1516 OLD MOCKSVILLE HWY STATESVILLE NC 28625

LOCATION 64 W (R) LONE PINE, 1ST BRICK HOUSE ON RT

SUBDIVISION BLOCK / SECTION LOT LOT AREA SITE CLASS DESIGN FLOW 240 L.T.A.R. .25

Septic Tank: EXISTING Gallons: STB Date

Pump Tank: Gallons: PT Date

Pump Make: Model Serial No

Nitrification Field: No Fields 1 Square Feet Linear Feet 340'

No Lines 3 Trench Width 36" Max Trench Bottom Depth 24"

☐ New System ☒ Repair System Type: I. II (III) IV. V. VI

System Description: GRAY 250 GAL REPAIR

Repair System Description: LP PANEL

Maintenance Agreement Required: ☐ Yes ☒ No

Gravel Depth ☐ Slab ☒ Crawl Space ☐ Basement w/plumbing ☐ Basement wo/plumbing

☒ House/Mod. Home No. Bedrooms 2

☐ Mobile Home No. Bathrooms 1

☐ Business No. Employees


☐ Other

Water Supply: ☐ Individual ☒ Public ☐ Community

Comments/Conditions: (1) OWNER PUMPED TANK PREVIOUSLY & INSTALLED NEW TEE (2) DISCUSSED FUTURE EXPANSION, THAT IS WHY WE INSTALLED 340' CHAMBERS, IF FUTURE RULES PERMIT, EXPANSION MAY BE PERMITTED FOR 480 GAL X .25 LTAR = 600/25 %RED.

Comments/Conditions: WITH A FRENCH DRAIN, THAT WOULD LEAVE LP PANEL REPAIR & OLD WELL WOULD NEED ABANDONED.

INITIAL SITE SKETCH

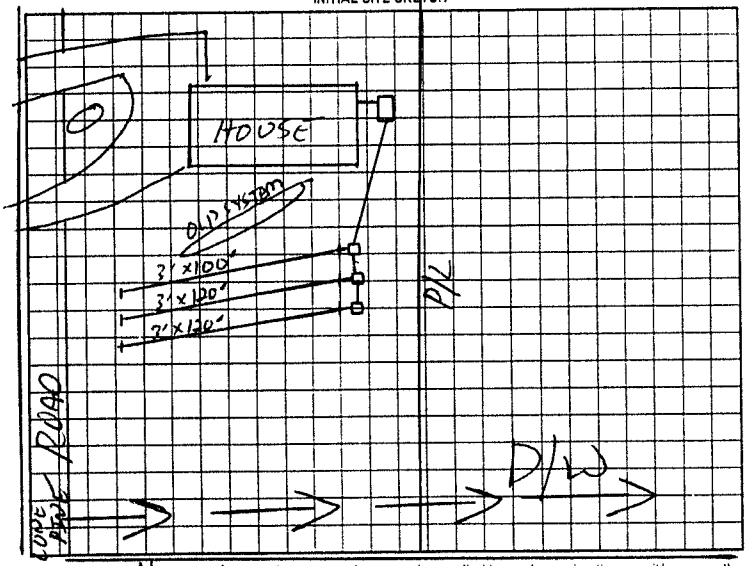

AS BUILT SKETCH

Permit can be suspended or revoked if any false information is supplied toward securing the permit/any unauthorized changes are made to the site/any unauthorized changes are made in the installation of the system. Improvement Permit with plat valid without expiration. Improvement Permit with site plan valid for sixty months. Authorization to Construct is valid for a period equal to that of Improvement Permit – not to exceed sixty months.

Signed: Matthew R Moorefield date 9-16-02

Improvement Permit by: date 9-16-02

Authorization to Construct by: date 9-16-02

Installed by: Johns Welding Inc

Operation Permit by: date 9-18-02

Existing System Inspection by: date

HEALTH DEPT COPY. WHITE OWNER COPY (FINAL) YELLOW OWNER COPY (INITIAL) PINK