CI

IREDELL COUNTY HEALTH DEPARTMENT

STATESVILLE 704-878-5305 MOORESVILLE 704-664-5281

IMPROVEMENT PERMIT / AUTHORIZATION TO CONSTRUCT / OPERATION PERMIT / EXISTING SYSTEM INSPECTION

PERMIT# 10080 PIN# 4765-93-7795, 7 DATE 10-12-01

OWNER OR CONTRACTOR A 17 INC. PHONE: Business 704-855-2300 Home

ADDRESS 450 AUCTION DR SALISBURY NC 28147

LOCATION HWY 64 E, (L) TRIPLE OAKS, 300 ON RIGHT

SUBDIVISION TRIPLE OAKS BLOCK / SECTION LOT 7 LOT AREA .4592 AC SITE CLASS PS DESIGN FLOW 360 L.T.A.R. .2

Septic Tank: 1000 Gallons: STB 825 Date 11-10-01
Pump Tank: Gallons: PT Date
Pump Make: Model Serial No.
Nitrification Field: No Fields 1 Square Feet EQ≈ 1800 Linear Feet 360'
No Lines 6 X50' Trench Width 24" Max Trench Bottom Depth (42") Gravel Depth N/A

[X] New System [ ] Repair System Type: I, II, (III), IV, V, VI
System Description: GRAV PANEL
Repair System Description: LP PANEL
Maintenance Agreement Required: [ ] Yes [X] No

[ ] House/Mod. Home No. Bedrooms 3
[ ] Mobile Home No. Bathrooms 2
[ ] Business No. Employees
[ ] Other


[X] Slab [ ] Crawl Space [ ] Basement w/plumbing [ ] Basement wo/plumbing

Water Supply: [ ] Individual [X] Public [ ] Community


Comments/Conditions: (1) INSTALL PANELS 42" DEEP & FRENCH DRAIN 54" DEEP (2) USE FLOW DIVIDER TEE & 2 DIST. BOX'S WITH SPEED LEVELERS (4) MAINTAIN SETBACKS (8) INSTALL LINES ON CONTOURS (9) USE 69 PANELS TO EQUAL 301' OF LINE

Comments/Conditions: (6) MAINTAIN SETBACKS (7) LIME & RAKE THE TRENCHES WALLS POLYLOK FILTER & MARKER 2 BOXES SET WITH SPEED LEVELERS

INITIAL SITE SKETCH

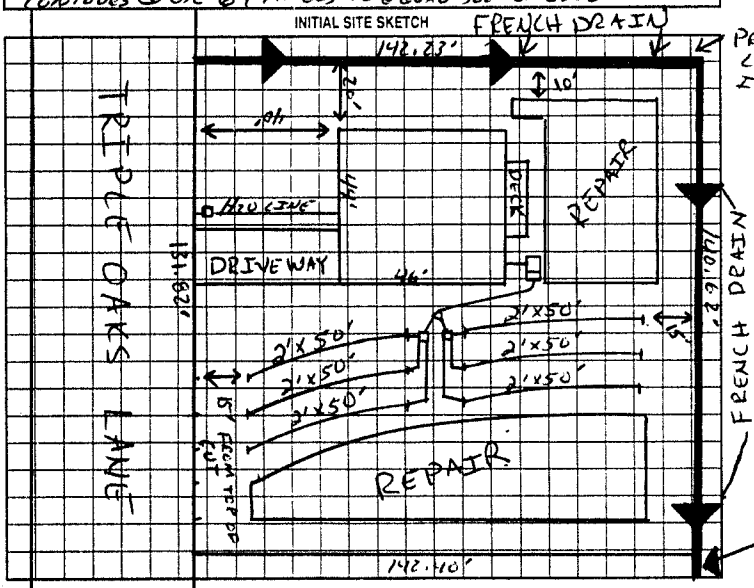

AS BUILT SKETCH

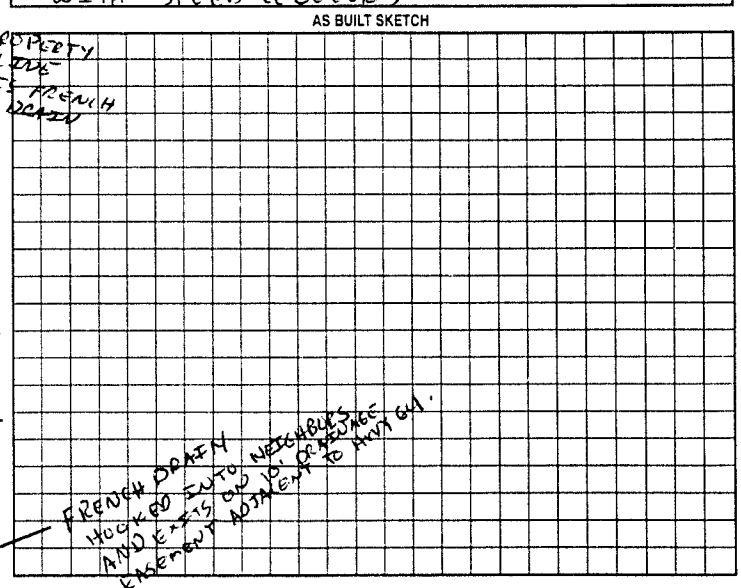

Permit can be suspended or revoked if any false information is supplied toward securing the permit/any unauthorized changes are made to the site/any unauthorized changes are made in the installation of the system. Improvement Permit with plat valid without expiration. Improvement Permit with site plan valid for sixty months. Authorization to Construct is valid for a period equal to that of Improvement Permit – not to exceed sixty months.

Signed: date 10/15/01 Installed by: ROWAN SEPTIC

Improvement Permit by: Jim Cook RS date 10-12-01 Operation Permit by: Jim Cook RS date 12-27-01

Authorization to Construct by: Jim Cook RS date 10-12-01 Existing System Inspection by: date

HEALTH DEPT. COPY WHITE OWNER COPY (FINAL) YELLOW OWNER COPY (INITIAL) PINK