CI

IREDELL COUNTY HEALTH DEPARTMENT

STATESVILLE 704-878-5305 MOORESVILLE 704-664-5281

IMPROVEMENT PERMIT / AUTHORIZATION TO CONSTRUCT / OPERATION PERMIT / EXISTING SYSTEM INSPECTION

PERMIT# 100781 PIN# 4765-93-7795.6 DATE 7-25-01

OWNER OR CONTRACTOR A H INC. PHONE: Business 704-855-2300 Home

ADDRESS 450 AUCTION DRIVE, SALISBURY, NC 28147

LOCATION HWY 64 E, ① TRIPLE OAKS IN CUL-DE-SAC ON RT

SUBDIVISION TRIPLE OAKS BLOCK / SECTION LOT 6 LOT AREA .53 AA SITE CLASS PS DESIGN FLOW 360 L.T.A.R. .25

Septic Tank: 1000 Gallons: STB B25 Date 5-31-01

Pump Tank: Gallons: PT Date

Pump Make: Model Serial No

Nitrification Field: No Fields 1 Square Feet 60 x 1440 Linear Feet 360

No Lines 5 Trench Width 36" Max Trench Bottom Depth 36"

X New System ☐ Repair System Type: I, II, (III), IV, V, VI

System Description: GRAV 25% RED

Repair System Description: LP PANEL

Maintenance Agreement Required: ☐ Yes X No

Gravel Depth N/A

X House/Mod. Home ☐ Mobile Home ☐ Business ☐ Other

No. Bedrooms 3 No. Bathrooms 2 No. Employees


☐ Slab X Crawl Space ☐ Basement w/plumbing ☐ Basement wo/plumbing

Water Supply: ☐ Individual X Public ☐ Community


Comments/Conditions: ① INSTALL FRENCH DRAIN 48" DEEP & TIE IN TO NEIGHBORS FRENCH DRAIN ON LOT 5 FOR OUTLET. ② MAINTAIN SETBACKS ③ USE DROP BOXES ④ INSTALL LINES ON CONTOURS ⑤ INSTALL 60 CHAMBERS OR 36 HDS SECTIONS

Comments/Conditions: POLY LOK FILTER INSTALLED AS SHOWN

INITIAL SITE SKETCH "NOT TO SCALE"

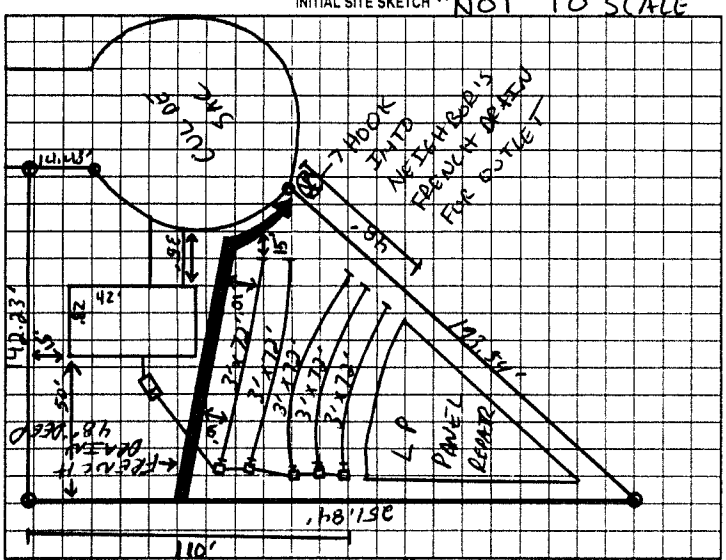

AS BUILT SKETCH

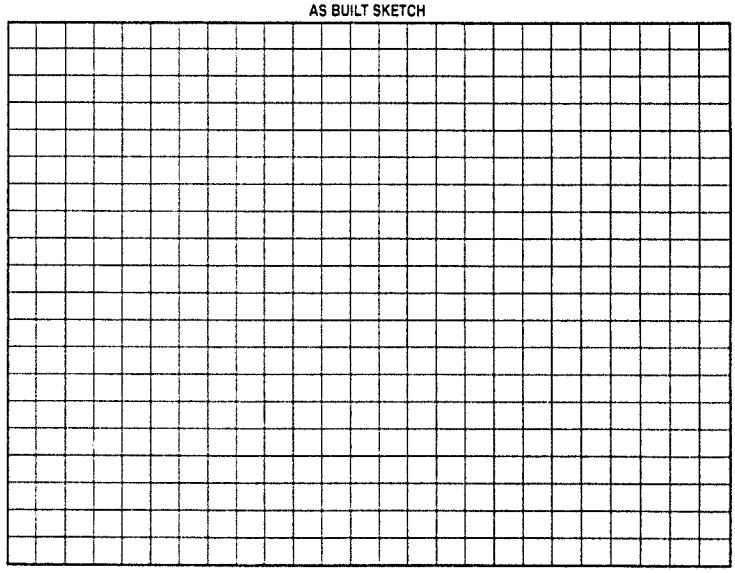

Permit can be suspended or revoked if any false information is supplied toward securing the permit/any unauthorized changes are made to the site/any unauthorized changes are made in the installation of the system. Improvement Permit with plat valid without expiration. Improvement Permit with site plan valid for sixty months. Authorization to Construct is valid for a period equal to that of Improvement Permit – not to exceed sixty months.

Signed: date 07/26/01 Installed by: ROWAN SEPTIC

Improvement Permit by: date 7-25-01 Operation Permit by: date 9-26-01

Authorization to Construct by: date 7-25-01 Existing System Inspection by: date

HEALTH DEPT COPY WHITE OWNER COPY (FINAL) YELLOW OWNER COPY (INITIAL) PINK