IREDELL COUNTY HEALTH DEPARTMENT

Statesville Phone TR 3-7271 Mooresville Phone NO 3-1271

PERMIT TO INSTALL SEPTIC TANK

Permit NO. _____ Permit Date 3-25 1960

Owner AC Cloer Address Winston Hwy.

Installed By C Hoke Address R 7 -


Location of Property left off 64 at Warren's Rock house beyound Beavers Store - ondirt drive

Tank		Capacity		Length of Lines		Fixtures	
Block	( )	800	( )	150'	( )	No. of Baths	(4)
Precast	(4)	900	(4)	175'	( )	Dishwasher	( )
		1000	( )	200'	( )	Garbage Grdr.	( )
Lash		1100	( )	225'	(4)	Auto-Washer	( )
		1200	( )	250'	( )	Other	
		Other		Other			

NOTIFY HEALTH DEPARTMENT AT LEAST EIGHT HOURS BEFORE TANK IS TO BE INSPECTED.

Final Inspection 3 25 1960 Approved ( ) Disapproved ( )

Remarks Selfapp - Mowed on Property

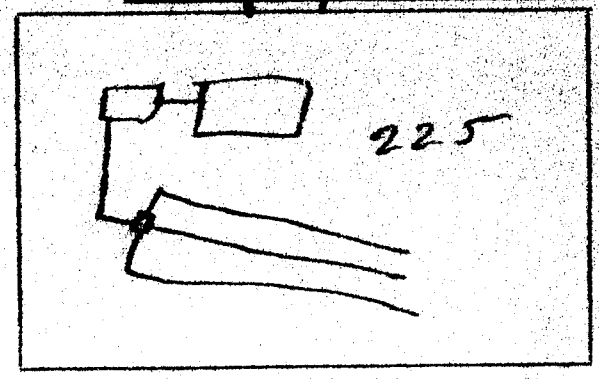

Sketch of Installation

R. A. 2.

Sanitarian