# IREDELL COUNTY HEALTH DEPARTMENT

STATESVILLE 704-878-5305 MOORESVILLE 704-664-5281

## IMPROVEMENT PERMIT / AUTHORIZATION TO CONSTRUCT / OPERATION PERMIT / EXISTING SYSTEM INSPECTION

PERMIT# 10131720 PIN# 4765-93-7795.4 DATE 6/20/01

OWNER OR CONTRACTOR AH INC. PHONE: Business 704-885-2300 Home

ADDRESS 450 AULTION DR, SALISBURY, NC 28147

LOCATION HWY 64E, (L) TRIPLE OAKS, LEFT IN CUL-DE-SAC

SUBDIVISION TRIPLE OAKS BLOCK / SECTION LOT 4 LOT AREA 0.5313 AC SITE CLASS IS DESIGN FLOW 360 L.T.A.R. .3

Septic Tank: 1000 Gallons. STB 825 Date 6-17-01
Pump Tank: Gallons. PT Date
Pump Make: Model Serial No
Nitrification Field: No Fields 1 Square Feet ED 12 1200' Linear Feet 300'
No Lines 6 Trench Width 36" Max Trench Bottom Depth 36"

X New System Repair System Type: I II III IV V VI
System Description: GRAV 25% REDUCT
Repair System Description: LP PANEL
Maintenance Agreement Required Yes X No
Gravel Depth N/A Slab X Crawl Space Basement w/plumbing Basement wo/plumbing


X House/Mod Home No. Bedrooms 3
Mobile Home No. Bathrooms 2
Business No Employees
Other

Water Supply: Individual X Public Community

Comments/Conditions: (1) INSTALL LINES ON CONTOUR & MAINTAIN SETBACKS (2) USE 4 ADAPTORS & 1 FLOW DIVIDER TEE (3) INSTALL FRENCH DRAIN (4) USE 50 CHAMBERS OR 30 HDX SECTIONS

Comments/Conditions: POLYLOK FILTER + MARKER

INITIAL SITE SKETCH 1" = 40'

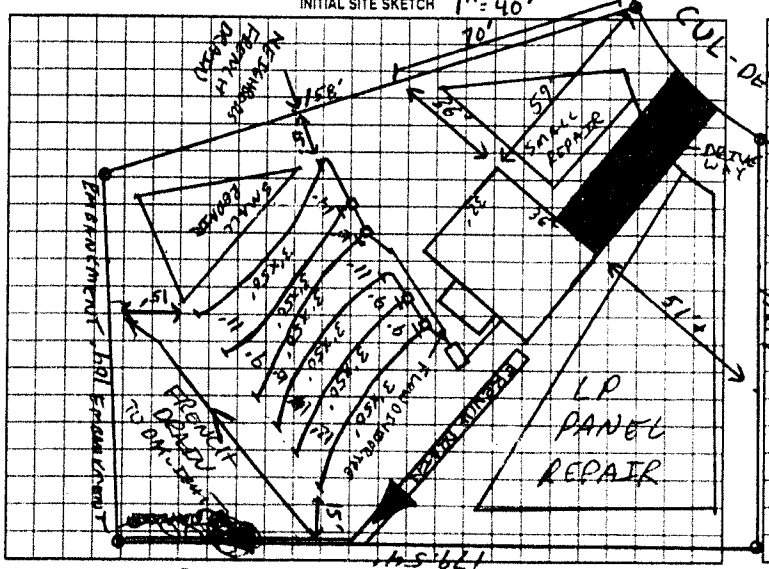


AS BUILT SKETCH

7 = 1 CHAMBERS IN EACH LINE
9 = 2
9 = 3
9 = 4
8 = 5
8 = 6
50

FRENCH DRAIN INSTALLED 10' ABOVE SYSTEM & 15' OFF SIDE OF SYSTEM

Permit can be suspended or revoked if any false information is supplied toward securing the permit, any unauthorized changes are made to the site, any unauthorized changes are made in the installation of the system. Improvement Permit with plat valid without expiration. Improvement Permit with site plan valid for sixty months. Authorization to Construct is valid for a period equal to that of Improvement Permit - not to exceed sixty months.

Signed: date 6/22/01

Improvement Permit by: date 6-20-01

Authorization to Construct by: date 6-2001

Installed by: LOWAN SEPTIC

Operation Permit by date 8-28-01

Existing System Inspection by: date

HEALTH DEPT. COPY: WHITE OWNER COPY (FINAL): YELLOW OWNER COPY (INITIAL): PINK