IREDELL COUNTY HEALTH DEPARTMENT

STATESVILLE 704-878-5305 MOORESVILLE 704-664-5281

IMPROVEMENT PERMIT / CERTIFICATE OF COMPLETION / OPERATION PERMIT / EXISTING SYSTEM INSPECTION

PROPERTY DESCRIPTION NO. 6959 DATE 9-26-97 TAX MAP NO. 4766158818 Watershed: ☐ Yes ☐ No

OWNER OR CONTRACTOR Dwight V. Anderson PHONE: Business _____ Home 704 872 1604

ADDRESS 360 Seek Hse Rd Sta

LOCATION old mocksville rd TR Chestnut Grove past Seek Hse Rd TL Private Drive

SUBDIVISION _____ BLOCK / SECTION _____ LOT _____ LOT AREA 2.14 acres SITE CLASS. PS DESIGN FLOW 240 L.T.A.R. .13

Septic Tank: 1000 Gallons; STB 1012 Date 7-15-97

Pump Tank: _____ Gallons; PT _____ Date _____

Pump Make: _____ Model _____ Serial No. _____

Nitrification Field: No Fields 1 Square Feet 840 Linear Feet 270

No Lines 3 Trench Width 36" Max Trench Bottom Depth 36" Gravel Depth 12"

☑ New System ☐ Repair System Type: I, II, III, IV, V, VI

System Description: conv. Gravity

Repair System Description: _____

Maintenance Agreement Required: ☐ Yes ☑ No

☐ House/Mod. Home No. Bedrooms 2

☑ Mobile Home No. Bathrooms 2

☐ Business No. Employees _____

☐ Other _____


☐ Slab ☑ Crawl Space ☐ Basement w/plumbing ☐ Basement wo/plumbing

Water Supply: ☑ Individual ☐ Community ☐ Public well


Comments:

Comments:

INITIAL SITE SKETCH

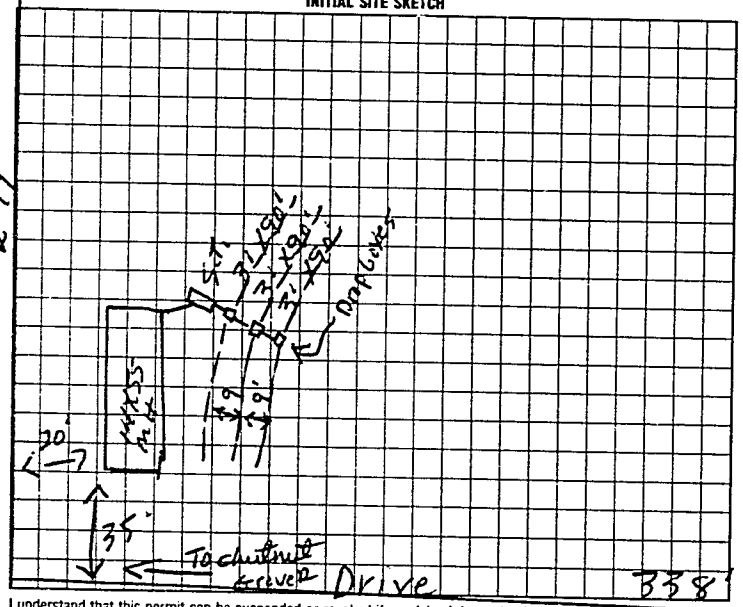

AS BUILT SKETCH

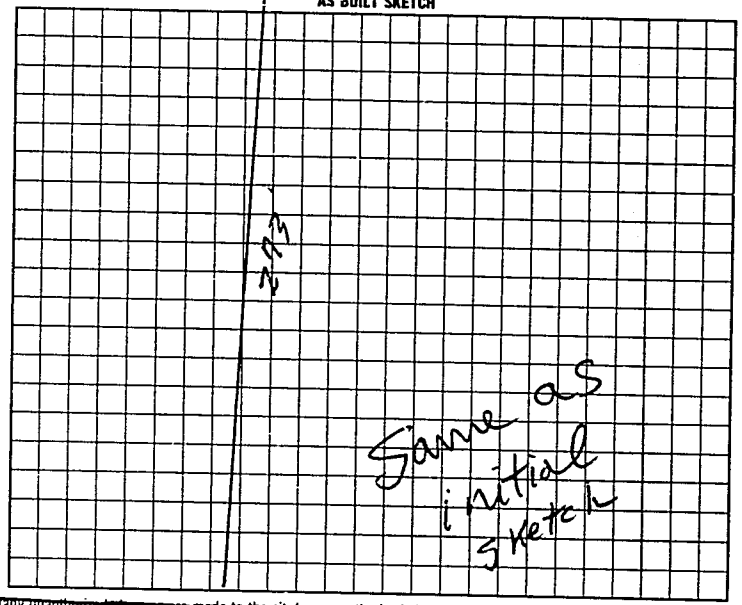

I understand that this permit can be suspended or revoked if any false information is supplied toward securing the permit/any unauthorized changes are made to the site/any unauthorized changes are made in the installation of the system. Improvement Permit is valid for 60 months from date of issuance.

Signed: Dwight V. Anderson

Improvement Permit by: P. C. Moore date 9-26-97

~~Authorized Agent~~ Engineering Specialist by: P. C. Moore date 9-26-97

HEALTH DEPT COPY WHITE INSPECTION COPY (FINAL) GREEN OWNER COPY (FINAL) YELLOW

Installed by: Steve Jordan

Certificate of Completion by: _____ date _____

Operation Permit by: P. C. Moore date 9-30-97

INSPECTION COPY (INITIAL) PINK OWNER COPY (INITIAL) GOLD

to Court.

Authorization to Court Expires 60 mos from issue

6 2 6 2 0 0