# IREDELL COUNTY HEALTH DEPARTMENT

STATESVILLE 704-878-5305 MOORESVILLE 704-664-5281

## IMPROVEMENT PERMIT / CERTIFICATE OF COMPLETION / OPERATION PERMIT / EXISTING SYSTEM INSPECTION

PROPERTY DESCRIPTION NO. ~~2597~~ Repair DATE 1-27-97

OWNER OR CONTRACTOR James R. Summers TAX MAP NO.

ADDRESS 238 Seed House Road PHONE: Business 872-6629 Home Watershed: ☐ Yes ☐ No

LOCATION Corner Seed House & Chestnut Grove Rd

SUBDIVISION BLOCK / SECTION LOT LOT AREA 2 acres ± SITE CLASS P5 DESIGN FLOW L.T.A.R. 1.3

Septic Tank: Ex. Gallons; STB Date

Pump Tank: Gallons; PT Date

Pump Make: Model Serial No.

Nitrification Field: No Fields 1 Square Feet 900 Linear Feet 300

No Lines 3 Trench Width 36" Max Trench Bottom Depth 36" Gravel Depth 12"

☐ New System ☑ Repair System Type: I (II) III, IV, V, VI

System Description:

Repair System Description: Conv. Gravity

Maintenance Agreement Required: ☐ Yes ☐ No

☑ House/Mod. Home No. Bedrooms 3

☐ Mobile Home No. Bathrooms 1

☐ Business No. Employees

☐ Other


☐ Slab ☑ Crawl Space ☐ Basement w/plumbing ☐ Basement wo/plumbing

Water Supply: ☐ Individual ☐ Community ☑ Public


Comments:

Comments: Replacing old Drainfield

INITIAL SITE SKETCH

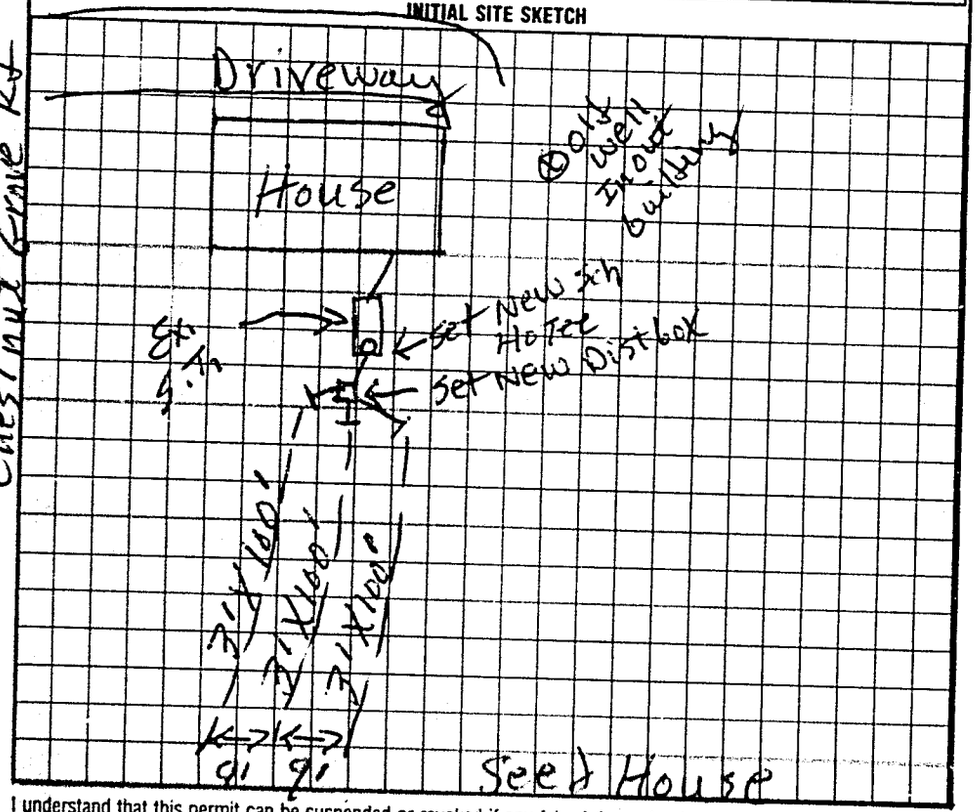


AS BUILT SKETCH

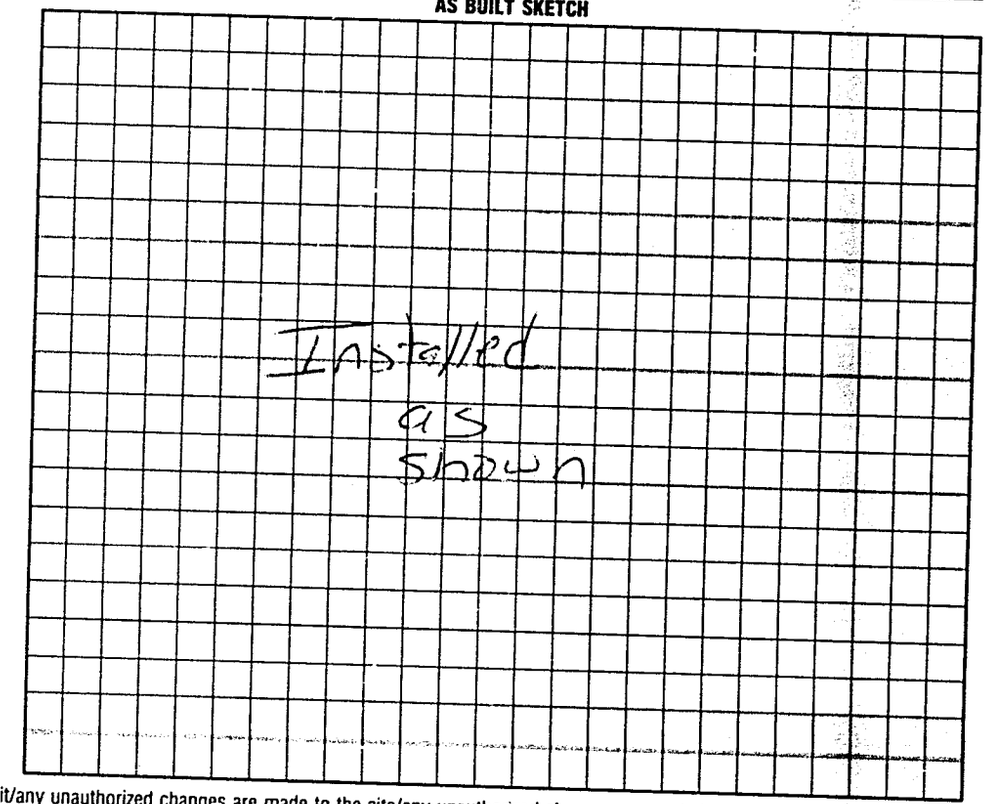


I understand that this permit can be suspended or revoked if any false information is supplied toward securing the permit/any unauthorized changes are made to the site/any unauthorized changes are made in the installation of the system. Improvement Permit is valid for 60 months from date of issuance.

Signed: James R. Summers

Improvement Permit by: L.C. Moore date 1-27-97

Authorization to Construct Existing System Inspection by: L.C. Moore date 1-27-97

Installed by: Steve Jordon

Certificate of Completion by: date

Operation Permit by: date 2-10-98

HEALTH DEPT COPY (WHITE) INSPECTION COPY (FINAL): GREEN OWNER COPY (FINAL): YELLOW INSPECTION COPY (INITIAL): PINK OWNER COPY (INITIAL): GOLD

Authorization to Const. Expires 60 mos from issue