IREDELL COUNTY HEALTH DEPARTMENT

Statesville Office (704) 878-5305 Mooresville Office (704) 660-3625 PERMIT # 179381 DRH

IMPROVEMENT PERMIT / AUTHORIZATION TO CONSTRUCT / OPERATION PERMIT / EXISTING SYSTEM

PIN # 4766165293

APPLICANT: Oakwood Mobile Homes APPLICANT ADDRESS: 1265 US Hwy 70 W Hickory, NC 28603

SITE ADDRESS: Chestnut Grove Rd PHONE: ALT. PHONE:

SITE DIRECTIONS: Old Mocksville Rd, (R) on Chestnut Grove Rd - behind 170

SUBDIVISION: n/a SECTION: n/a LOT # n/a LOT AREA: .59 Acres DESIGN FLOW: 480 L.T.A.R.: .3

Septic Tank 1000 (gal) STB 786 Date 7-11-13
Pump Tank (gal) PT Date
Pump Make Model Serial #
Nitrification Fields 1 # Lines Linear Ft: 400
Trench Width 36" Max. Trench Bottom Depth 36" Gravel Depth n/a


[X] New System [ ] Repair [ ] Expansion System Type: I II (III) IV V VI
System Description: 25% Reduction Gravity LP
Repair System Description: 50% Reduction LP
Maintenance Agreement Required: [ ] YES [X] NO
[X] GRAVITY [ ] PRESSURE

[X] Residence No. Bedrooms 4
[ ] Business No. Persons
[ ] Other No. Employees
[ ] Slab [X] Crawl Space
[ ] Basement w/plumbing [ ] Basement w/o plumbing

Water Supply: [X] Private [X] Public [ ] Community

Comments / Conditions:

INITIAL SITE SKETCH

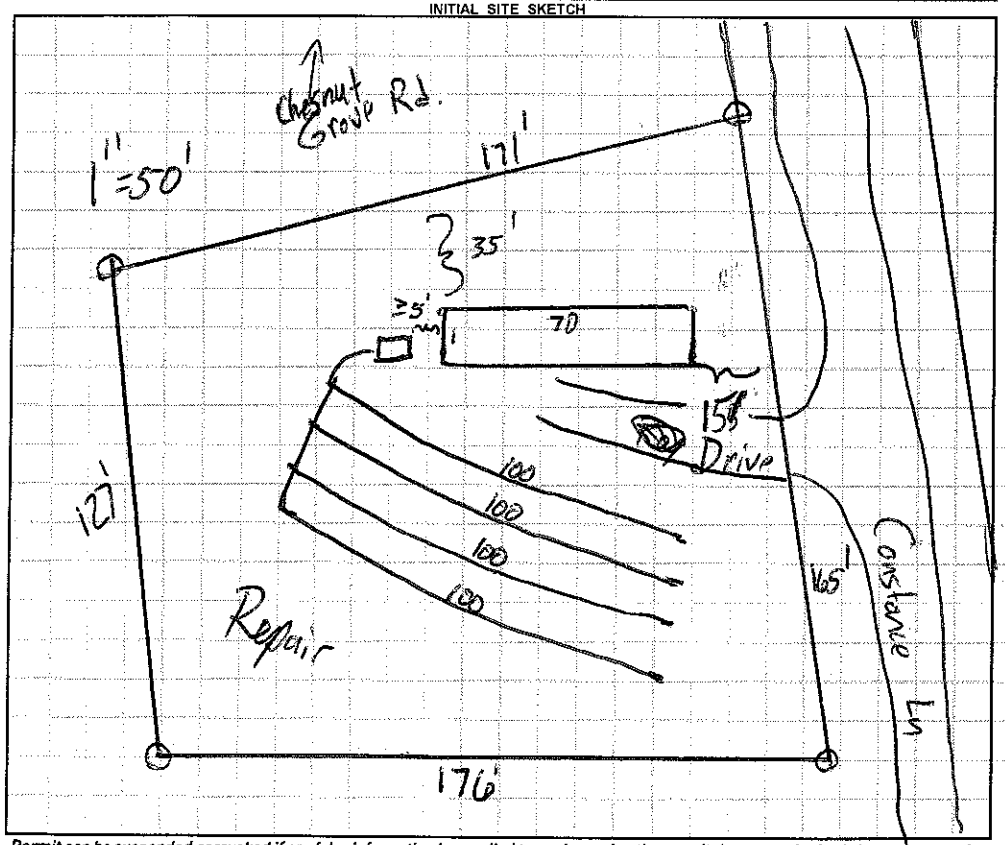

AS BUILT SKETCH

Permit can be suspended or revoked if any false information is supplied toward securing the permit / any unauthorized changes are made to the site / any unauthorized changes are made in the installation of the system. **CONTACT A LOCATOR SERVICE PRIOR TO ANY EXCAVATION**

[ ] **IMPROVEMENT PERMIT** *with plat valid without expiration.* [X] **IMPROVEMENT PERMIT** *with site plan valid for 60 mos.* [X] **AUTHORIZATION TO CONSTRUCT** *valid for period equal to IMPROVEMENT PERMIT--not to exceed 60 mo.*

Owner / Applicant Signature: Shawn Abee for Oakwood Homes Date: 8-14-13 Installed by: Shawn Abee

IMPROVEMENT PERMIT by: Date: 8-12-13 OPERATION PERMIT by: Date: 9-12-13

AUTHORIZATION TO CONSTRUCT by: Date: 8-12-13 Existing System Inspected by: Date:

Health Dept. Copy - WHITE Applicant (Final Approval) - YELLOW Applicant (Conditional Approval) - PINK