IREDELL COUNTY HEALTH DEPARTMENT

STATESVILLE 704-878-5305 MOORESVILLE 704-664-5281

IMPROVEMENT PERMIT / AUTHORIZATION TO CONSTRUCT / OPERATION PERMIT / EXISTING SYSTEM INSPECTION

PERMIT# _____ PIN# _____ DATE 12-7-99

OWNER OR CONTRACTOR Charles Feimster PHONE: Business _____ Home 878 2951

ADDRESS 210 Chestnut Grove Rd

LOCATION 64E TO Statesville TR Chestnute Grove Rd across from community Center

SUBDIVISION _____ BLOCK / SECTION _____ LOT _____ LOT AREA 2 acres SITE CLASS _____ DESIGN FLOW _____ L.T.A.R. .35

Septic Tank: Ex. Gallons; STB _____ Date _____

Pump Tank: _____ Gallons; PT _____ Date _____

Pump Make: _____ Model _____ Serial No. _____

Nitrification Field: No Fields 1 Square Feet 720 Linear Feet 240

No Lines 2 Trench Width 36" Max Trench Bottom Depth 36" Gravel Depth 12"

☐ New System ☑ Repair System Type: I (II) III. IV. V. VI

System Description: _____

Repair System Description: conv. Gravity

Maintenance Agreement Required: ☐ Yes ☑ No

☑ House/Mod. Home No. Bedrooms 3

☐ Mobile Home No. Bathrooms 2

☐ Business No. Employees _____

☐ Other _____


☐ Slab ☑ Crawl Space ☐ Basement w/plumbing ☐ Basement wo/plumbing

Water Supply: ☑ Individual ☐ Public ☐ Community

Comments:/Conditions:

Comments:/Conditions:

INITIAL SITE SKETCH

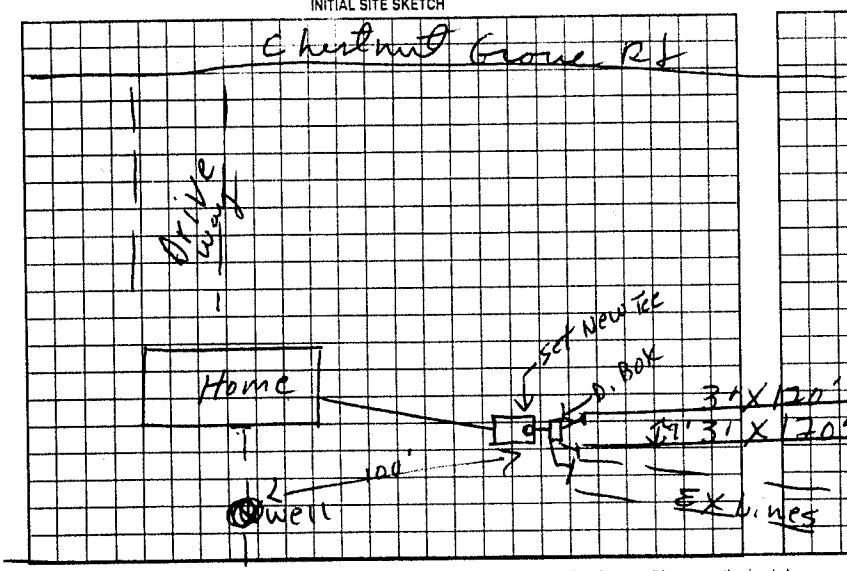

AS BUILT SKETCH

Same as initial Sketch

Permit can be suspended or revoked if any false information is supplied toward securing the permit/any unauthorized changes are made to the site/any unauthorized changes are made in the installation of the system. Improvement Permit with plat valid without expiration. Improvement Permit with site plan valid for sixty months. Authorization to Construct is valid for a period equal to that of Improvement Permit – not to exceed sixty months.

Signed: X Charles N. Feimster date _____ Installed by: Andy Daniels

Improvement Permit by: P. C. moore date 12-7-99 Operation Permit by: P. C. moore date 12-29-99

Authorization to Construct by: P. C. moore date 12-7-99 Existing System Inspection by: _____ date _____

HEALTH DEPT. COPY: WHITE OWNER COPY (FINAL) YELLOW OWNER COPY (INITIAL) PINK