IREDELL COUNTY HEALTH DEPARTMENT

STATESVILLE 704-878-5305 MOORESVILLE 704-664-5281 49693

IMPROVEMENT PERMIT / CERTIFICATE OF COMPLETION / OPERATION PERMIT / EXISTING SYSTEM INSPECTION

PROPERTY DESCRIPTION NO. 17164 DATE 10-7-93 TAX MAP NO PT 11E-A-15

OWNER OR CONTRACTOR Joe Houpe PHONE: Business Home 873 5765

ADDRESS 2019 Joe Houpe Rd

LOCATION 64E to TR Statesville to TR Chestnut Grove Rd before Old School Chestnut Grove on left

SUBDIVISION BLOCK / SECTION LOT LOT AREA 2.5 acres SITE CLASS. P.S. L.T.A.R. .35 gal/ss/day

Water Supply: ☑ Individual ☐ Community ☐ Public

Septic Tank: 1000 Gallons; STB 1012 Date 4-16-94

Pump Tank: Gallons; PT Date

Nitrification Field: No Fields 1 Square Feet 1035 Linear Feet 345

No Lines 3 Trench Width 36" Trench Depth 18+36" Gravel Depth 12"

☑ New System ☐ Repair System Type: I, II, III, IV, V, VI

System Description: Conv. Gravity

Repair System Description: Conv. Gravity

Maintenance Agreement Required: ☐ Yes ☑ No

☐ House/Mod. Home No. Bedrooms 3

☐ Mobile Home No. Bathrooms 2 1/2

☐ Business No. Employees

☐ Other

☐ Slab ☐ Crawl Space ☐ Basement w/plumbing ☑ Basement wo/plumbing

Garbage Disposal: ☐ Yes ☐ No


Auto. Dishwasher: ☐ Yes ☐ No

Auto. Washing Machine: ☐ Yes ☐ No

Other

Comments Well was not located at time of this inspection Place at least 100' from S.T. systems as shown

INITIAL SITE SKETCH

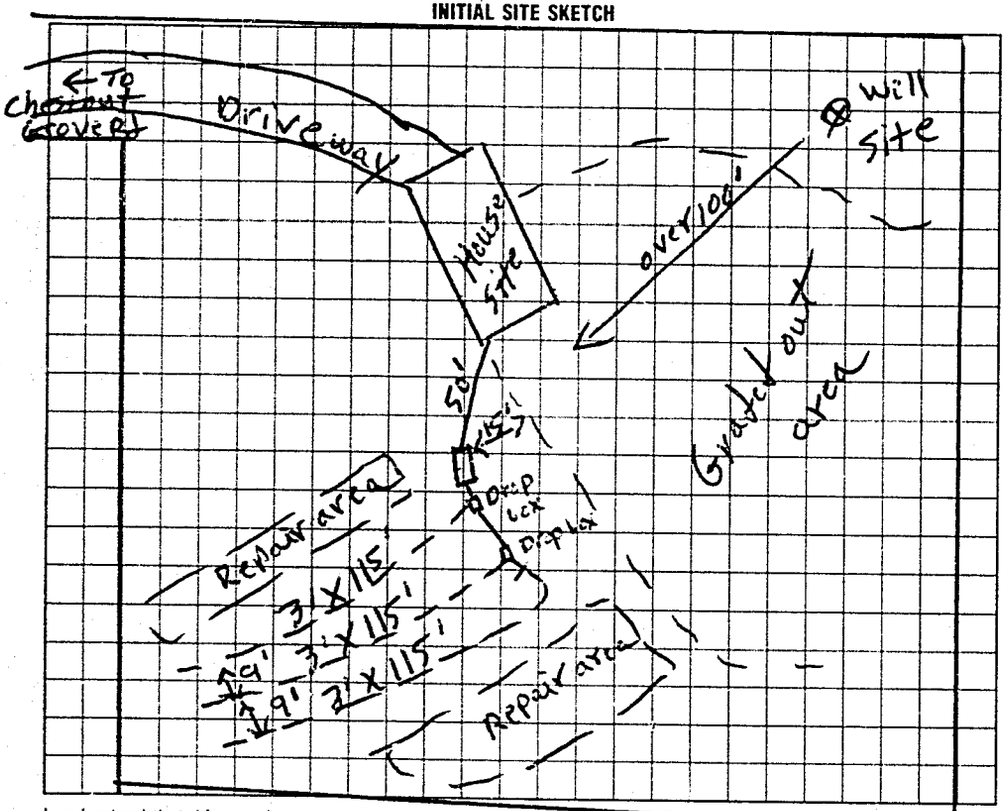

AS BUILT SKETCH

Same as initial Sketch

I understand that this permit can be suspended or revoked if any false information is supplied toward securing the permit/any unauthorized changes are made to the site/any unauthorized changes are made in the installation of the system. Improvement Permit is valid for 60 months from date of issuance.

Signed: X Marten Hendricks

Improvement Permit by: L. C. Moore date 10-7-93

Existing System Inspection by: date

Installed by: James Hutler

Certificate of Completion by: L. C. Moore date 7-12-94

Operation Permit by: date

HEALTH DEPT COPY WHITE INSPECTION COPY (FINAL) GREEN OWNER COPY (FINAL) YELLOW INSPECTION COPY (INITIAL) PINK OWNER COPY (INITIAL) GOLD