IREDELL COUNTY HEALTH DEPARTMENT

STATESVILLE 704-878-5305 MOORESVILLE 704-664-5281

IMPROVEMENT PERMIT / AUTHORIZATION TO CONSTRUCT / OPERATION PERMIT / EXISTING SYSTEM INSPECTION

PERMIT # 156710 PIN # 4766-29-6723 DATE 6-23-09

OWNER or APPLICANT Marshal Goodwin (Clayton PHONE: Business Home:

OWNER or APPLICANT ADDRESS Neal Road Statesville N C 28625

LOCATION / DIRECTIONS Old Mocksville Road Past Chestnut on right

SUBDIVISION BLOCK / SECTION LOT # LOT AREA DESIGN FLOW 310 L.T.A.R. 1258

Septic Tank 1250/1000 Gallons: STB 1250 Date 2008

Pump Tank Gallons: P T Date

Pump Make Model Serial #

Nitrification Field No Fields No Lines Linear Feet

Trench Width 36" Max. Trench Bottom Depth 24" Gravel Depth 12" GRAVITY PRESSURE

~~New System~~ Repair Expansion System Type I II III IV V VI

System Description: Braun's Conventional

Repair System Description: Braun's pump

Maintenance Agreement Required YES NO

Residence No. Bedrooms 3

Business No. Persons

Other No. Employees

Slab Crawl Space


Basement w/plumbing Basement w/o plumbing

Water Supply: Private Public Community


Comments / Conditions

Comments / Conditions

INITIAL SITE SKETCH

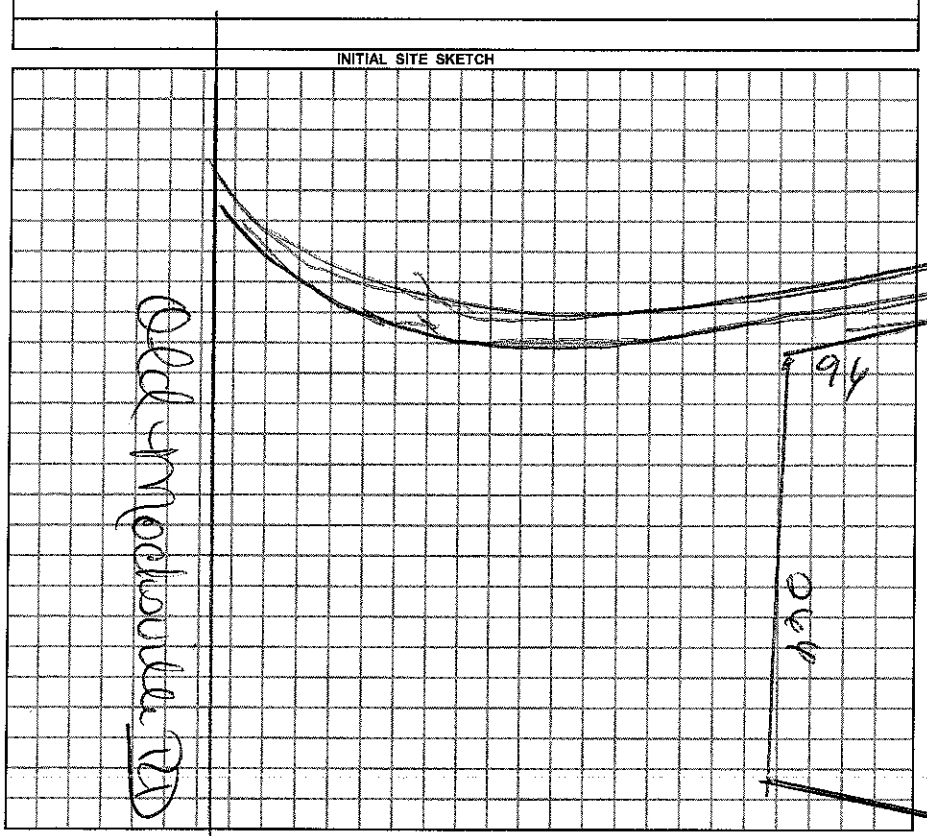

AS BUILT SKETCH

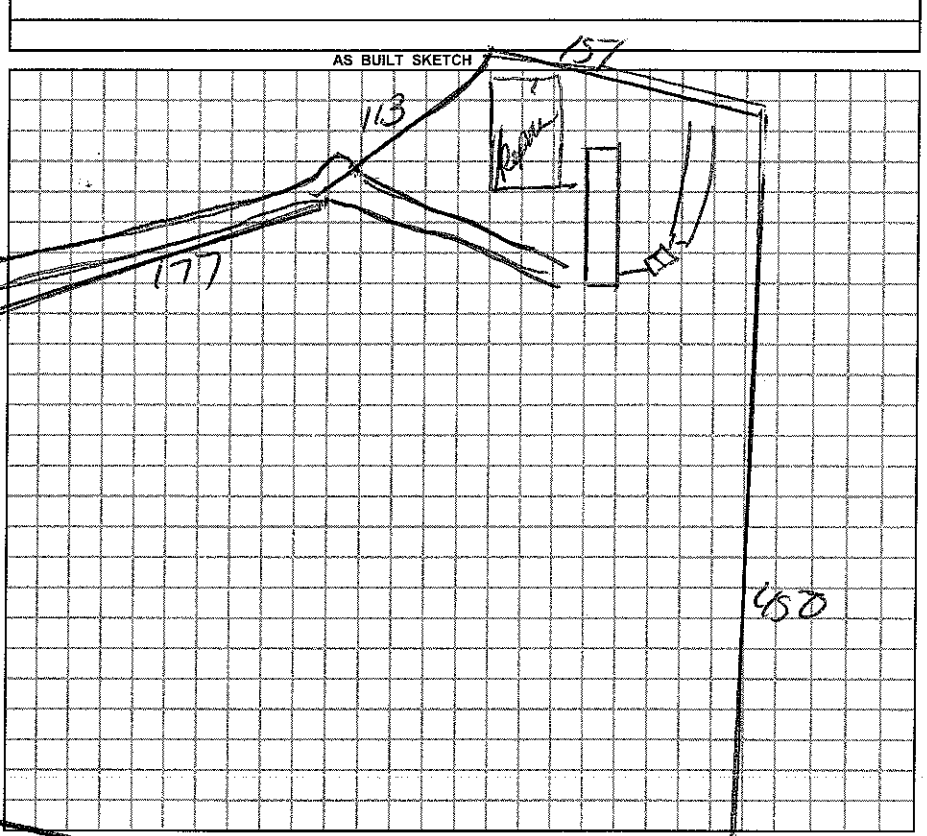

Permit can be suspended or revoked if any false information is supplied toward securing the permit / any unauthorized changes are made to the site / any unauthorized changes are made in the installation of the system.

☐ *IMPROVEMENT PERMIT w / plat valid without expiration.* ☐ *IMPROVEMENT PERMIT w / site plan valid for 60 mos.* ☒ *AUTHORIZATION TO CONSTRUCT valid for period equal to IMPROVEMENT PERMIT not to exceed 60 mo.*

Owner / Applicant Signature: Date 7/1/09

Improvement Permit by: Date

Authorization to Construct by: Date

Installed by:

Operation Permit by: Date:

Existing System Inspected by: Date: 6-23-09

YOU SHOULD CONTACT A LOCATOR SERVICE PRIOR TO ANY EXCAVATION.

WHITE COPY Environmental Health YELLOW COPY (Final) Owner / Applicant PINK COPY (Initial) Owner / Applicant