IREDELL COUNTY HEALTH DEPARTMENT

STATESVILLE 704-878-5305 (O) MOORESVILLE 704-664-5281

IMPROVEMENT PERMIT / AUTHORIZATION TO CONSTRUCT / OPERATION PERMIT / EXISTING SYSTEM INSPECTION

PERMIT# 125702 PIN# 4766-24-9047 331868 DATE 1-18-05

OWNER OR CONTRACTOR KENNETH ODOM PHONE: Business 704-682-4198 Home 704-873-6406

ADDRESS 119 B DEER CHASE CIR STATESVILLE, NC 28625

LOCATION OLD MOCKSVILLE ROAD, TR CHESTNUT GROVE ROAD, TR ALLEN CREEK ROAD, 0.4 MILE ON RIGHT

SUBDIVISION _____ BLOCK / SECTION _____ LOT _____ LOT AREA 1.00 ACRE SITE CLASS. PS DESIGN FLOW 480 L.T.A.R. 0.30 GPD/FT

Septic Tank: 1000 Gallons; STB 620 Date 2-9-05
Pump Tank: _____ Gallons; PT _____ Date _____
Pump Make: _____ Model _____ Serial No. _____
Nitrification Field: No Fields 1 Square Feet Eq. To 1600 Linear Feet 270
No Lines SIX Trench Width 24" Max Trench Bottom Depth 36"

☒ New System ☐ Repair System Type: I, II, III, IV, V, VI
System Description: 50% REDUCTION, GRAVITY
Repair System Description: 50% REDUCTION LOW PRESSURE
Maintenance Agreement Required: ☐ Yes ☒ No
Gravel Depth SAND 24" ☐ Slab ☒ Crawl Space ☐ Basement w/plumbing ☐ Basement wo/plumbing


☒ House/Mod. Home No. Bedrooms 4
☐ Mobile Home No. Bathrooms _____
☐ Business No. Employees _____
☐ Other _____

Water Supply: ☒ Individual ☐ Public ☐ Community
WELL


Comments:/Conditions: INSTALL 50% REDUCTION SYSTEM ON CONTOUR USING SIXTY (60) PPBPS PANELS. USE ONE FLOW DIVIDER TEE TO ACHIEVE EQUAL DISTRIBUTION INTO TWO EFFLUENT SPLITTERS (SUCH AS "ZOELLER - TRU-FLO")

Comments:/Conditions: SEPTIC TANK WITH MARKER INSTALLED USING "THETIS" FILTER

INITIAL SITE SKETCH

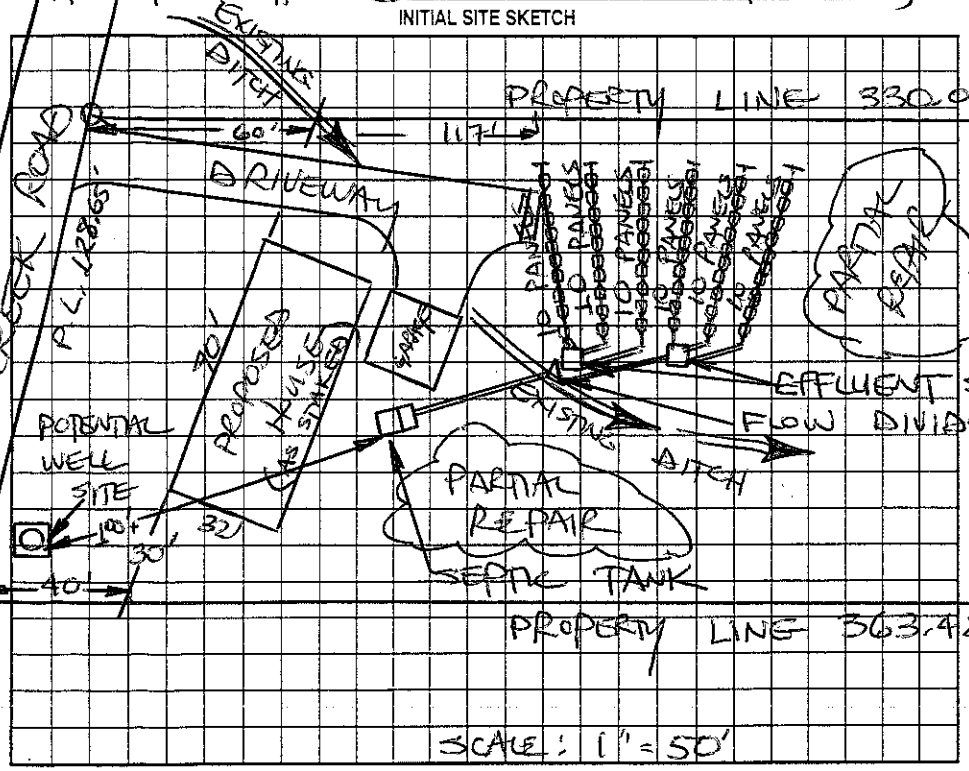

AS BUILT SKETCH

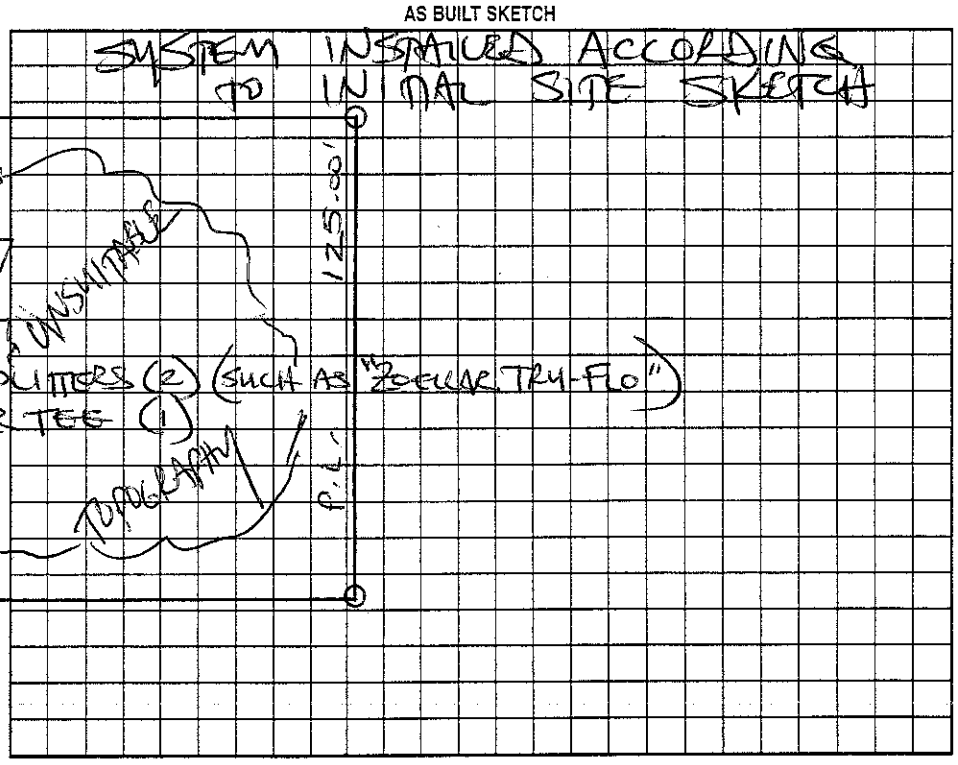

Permit can be suspended or revoked if any false information is supplied toward securing the permit/any unauthorized changes are made to the site/any unauthorized changes are made in the installation of the system. Improvement Permit with plat valid without expiration. Improvement Permit with site plan valid for sixty months. Authorization to Construct is valid for a period equal to that of Improvement Permit – not to exceed sixty months.

Signed: Kenneth E. Odom date 1-31-05 Installed by: SAMMY REAVIS

Improvement Permit by: STEVE HEDRICK date 1-18-05 Operation Permit by: STEVE HEDRICK date 6-24-05

Authorization to Construct by: STEVE HEDRICK date 1-18-05 Existing System Inspection by: _____ date _____

HEALTH DEPT. COPY: WHITE OWNER COPY (FINAL): YELLOW OWNER COPY (INITIAL): PINK