IREDELL COUNTY HEALTH DEPARTMENT

Statesville Office (704) 878-5305 Mooresville Office (704) 660-3625 PERMIT # 211713

IMPROVEMENT PERMIT / AUTHORIZATION TO CONSTRUCT / OPERATION PERMIT / EXISTING SYSTEM

PIN # 4766341663 ✓

APPLICANT: Abee's Clearing & Grading APPLICANT ADDRESS: 2381 US Hwy 64 West

SITE ADDRESS: 770 Allen Creek Rd. PHONE: 704-239-3693 ALT. PHONE: N/A


SITE DIRECTIONS: Hwy 64 E TL Old Mocksville Rd TR Chestnut Grove Rd TR Allen Creek Rd.

SUBDIVISION: Alisha Nicole Morrison SECTION: N/A LOT # - 1 - LOT AREA: 0.995 acres DESIGN FLOW: 360 gpd L.T.A.R.: 0.275


Septic Tank	1000 (gal)	STB	760	Date	9-26-15	☑ New System ☐ Repair ☐ Expansion	System Type: I II (III) IV V VI	☑ Residence	No. Bedrooms	3	Water Supply
Pump Tank	N/A (gal)	PT	N/A	Date	N/A	System Description:	25% Reduction	☐ Business	No. Persons	6	☐ Private
Pump Make	N/A	Model	Pohl 10	Serial #	PL-68	Repair System Description:	DRIP	☐ Other	No. Employees		☑ Public
# Nitrification Fields	1	# Lines	4	Linear Ft:	328	Maintenance Agreement Required:	☐ YES ☑ NO	☐ Slab	☑ Crawl Space		☐ Community
Trench Width	36"	Max. Trench Bottom Depth	30"	Gravel Depth	N/A		☑ GRAVITY ☐ PRESSURE	☐ Basement w/plumbing		☐ Basement w/o plumbing	

Comments / Conditions: IMPROVEMENTS ONLY: Record Proposed Property lines prior to ISSUANCE of CPT. Install a 25% Reduction system on contour with serial distribution. * Fill in small drainage way @ location shown below * Install trench bottoms @ 30"

INITIAL SITE SKETCH

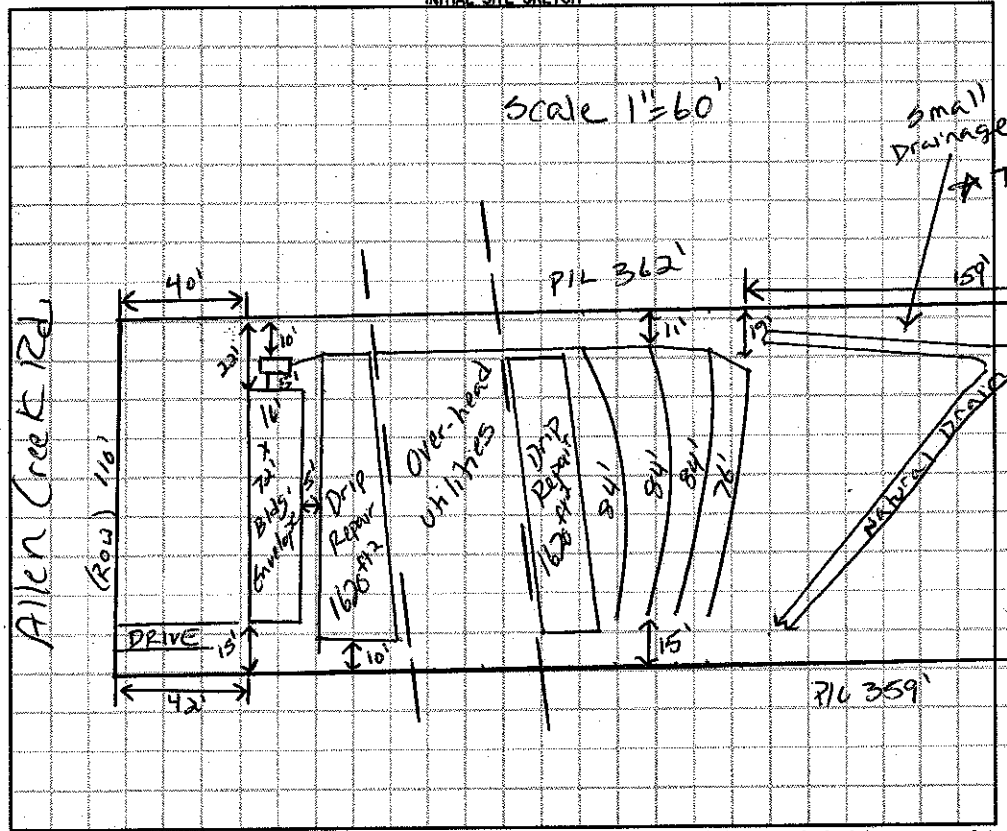

AS BUILT SKETCH

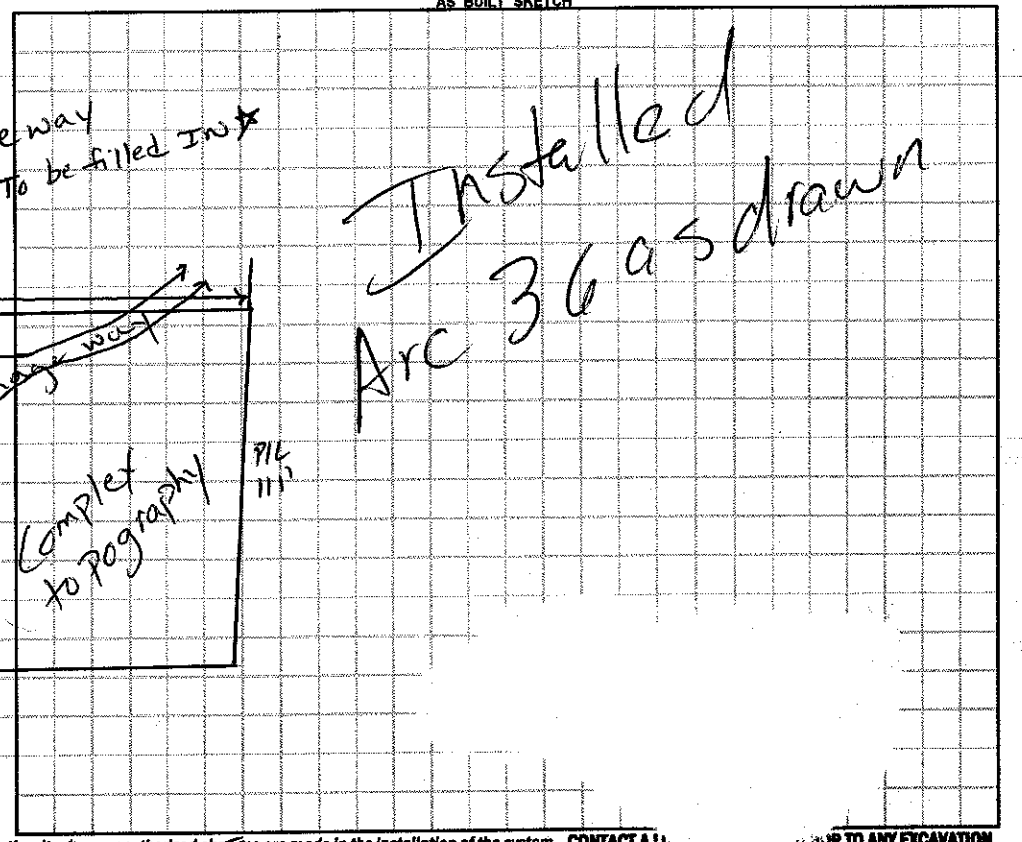

Permit can be suspended or revoked if any false information is supplied toward securing the permit / any unauthorized changes are made to the site / any unauthorized changes are made in the installation of the system. CONTACT A LI... ...OR TO ANY EXCAVATION

☐ **IMPROVEMENT PERMIT** *with plat valid without expiration.* ☑ **IMPROVEMENT PERMIT** *with site plan valid for 60 mos.* ☑ **AUTHORIZATION TO CONSTRUCT** *valid for period equal to IMPROVEMENT PERMIT--not to exceed 60 mo.*

Owner / Applicant Signature: Debra Abee Date: 8/21/15 Installed by: Abee's Grading

IMPROVEMENT PERMIT by: Justin Henderson Date: 8-20-15 OPERATION PERMIT by: [signature] Date: 02/11/16

AUTHORIZATION TO CONSTRUCT by: Justin Henderson Date: 1/6/16 Existing System Inspected by: Date:

Health Dept. Copy - WHITE Applicant (Final Approval) - YELLOW Applicant (Conditional Approval) - PINK