IREDELL COUNTY HEALTH DEPARTMENT

STATESVILLE 704-878-5305 MOORESVILLE 704-664-5281

IMPROVEMENT PERMIT / AUTHORIZATION TO CONSTRUCT / OPERATION PERMIT / EXISTING SYSTEM INSPECTION

PERMIT# 110322 PIN# 4766-35-6390 DATE 01-14-03

OWNER OR CONTRACTOR WANDA BRUNNER PHONE: Business 828-464-0767 Home 704-635-5828

ADDRESS 741 ALLEN CREEK RD STATESVILLE, NC 28625

LOCATION 64 EAST ⓛ OLD MOCKSVILLE RD, ⓡ CHESTNUT GROVE, ⓡ ALLEN CREEK 2ND HOUSE ON LEFT BESIDE

SUBDIVISION _____ BLOCK / SECTION _____ LOT _____ LOT AREA .85AC SITE CLASS. PS DESIGN FLOW 480 L.T.A.R. .3

Septic Tank: 1000 Gallons; STB 821 Date 1-14-03

Pump Tank: 1000 Gallons; PT 40 Date REBOUND

Pump Make: _____ Model _____ Serial No. HARNED V

Nitrification Field: No Fields 1 Square Feet EQ=1600 Linear Feet 400'

No Lines 5X80' Trench Width 36" Max Trench Bottom Depth 36" Gravel Depth N/A

☒ New System ☐ Repair System Type: I, II, (III) IV, V, VI

System Description: PUMP 25% REDUCT

Repair System Description: LP PANEL

Maintenance Agreement Required: ☐ Yes ☒ No

☐ House/Mod. Home No. Bedrooms 4

☒ Mobile Home DW No. Bathrooms 2

☐ Business No. Employees ____

☐ Other _____


☐ Slab ☒ Crawl Space ☐ Basement w/plumbing ☐ Basement wo/plumbing

Water Supply: ☒ Individual ☐ Public ☐ Community WELL


Comments/Conditions: ① MUST CALL & MEET HEALTH DEPT PRIOR TO EXCAVATION TO DISCUSS POSITIVE DRAINAGE. ② SYSTEM & HOUSE IS FLAGGED OUT. ③ MAINTAIN SETBACKS ④ DURING CONSULTATIVE VISIT WE'LL DISCUSS

Comments/Conditions: PUMP SIZING, ⑤ FLAG OUT 302.72' SIDELINE CORRECTLY B4 INSTALLATION.

INITIAL SITE SKETCH

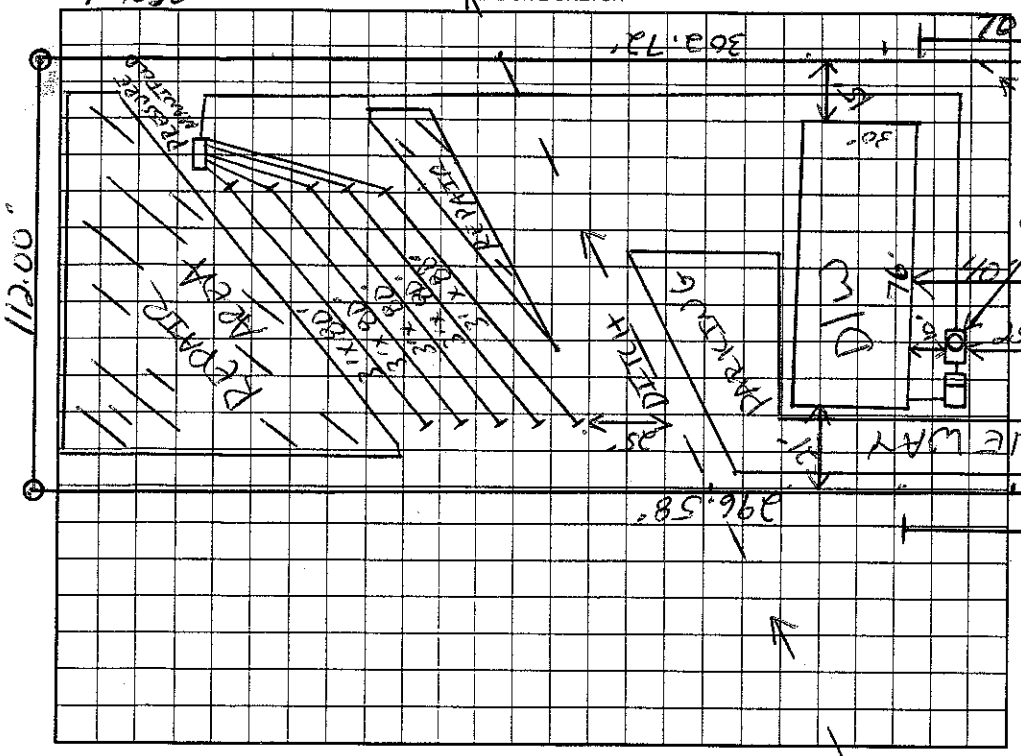

POTENTIAL

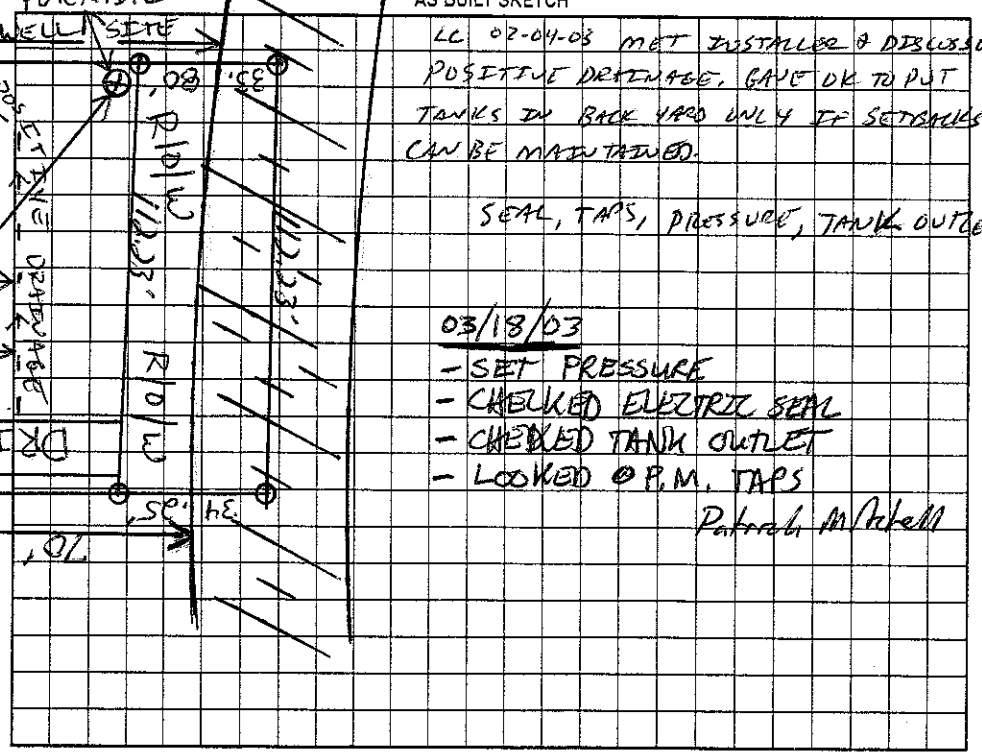

AS BUILT SKETCH

LC 02-04-03 MET INSTALLER & DISCUSSED POSITIVE DRAINAGE, GAVE OK TO PUT TANKS IN BACK YARD ONLY IF SETBACKS CAN BE MAINTAINED.

SEAL, TAPS, PRESSURE, TANK OUTLET

03/18/03
- SET PRESSURE
- CHECKED ELECTRIC SEAL
- CHECKED TANK OUTLET
- LOOKED @ P.M. TAPS

Patrick Mitchell

Permit can be suspended or revoked if any false information is supplied toward securing the permit/any unauthorized changes are made to the site/any unauthorized changes are made in the installation of the system. Improvement Permit with plat valid without expiration. Improvement Permit with site plan valid for sixty months. Authorization to Construct is valid for a period equal to that of Improvement Permit – not to exceed sixty months.

Signed: Wanda D. Brunner date _____ Installed by: D&D GRADING

Improvement Permit by: [signature] date 01-14-03 Operation Permit by: Patrick Mitchell date 03/18/03

Authorization to Construct by: [signature] date 01-14-03 Existing System Inspection by: _____ date _____

HEALTH DEPT. COPY: WHITE OWNER COPY (FINAL): YELLOW OWNER COPY (INITIAL): PINK