IREDELL COUNTY HEALTH DEPARTMENT

STATESVILLE 704-878-5305 (C) MOORESVILLE 704-664-5281

IMPROVEMENT PERMIT / AUTHORIZATION TO CONSTRUCT / OPERATION PERMIT / EXISTING SYSTEM INSPECTION

PERMIT# 133487 PIN# 4766362613 DATE 2-14-06

OWNER OR CONTRACTOR Johnny Lamar Mitchell PHONE: Business 704 902 4458 Home

ADDRESS Chestnut Grove Rd

LOCATION Old Mocksville Rd - (R) on Chestnut Grove - property on (L) past community center

SUBDIVISION Chestnut Acres BLOCK / SECTION LOT 6 LOT AREA 1.08 Acres SITE CLASS PS DESIGN FLOW 360 L.T.A.R. .3

Septic Tank: 1000 Gallons; STB 760 Date 5-13-06
Pump Tank: Gallons; PT Date
Pump Make: Model Serial No.
Nitrification Field: No Fields 1 Square Feet 1200 Linear Feet 300
No Lines 4 Trench Width 3' Max Trench Bottom Depth 3 Gravel Depth N/A

☐ New System ☐ Repair System Type: I (II) III IV V VI
System Description: 25% Reduction - Gravity
Repair System Description: 25% Reduction - Gravity
Maintenance Agreement Required: ☐ Yes ☒ No


☒ House/Mod. Home No. Bedrooms 3
☐ Mobile Home No. Bathrooms
☐ Business No. Employees
☐ Other
☒ Slab ☐ Crawl Space ☐ Basement w/plumbing ☐ Basement wo/plumbing

Water Supply: ☐ Individual ☒ Public ☐ Community


Comments:/Conditions:

Comments:/Conditions: SEPTIC TANK WITH MARKER INSTALLED USING RED "POLYLOK" FILTER

INITIAL SITE SKETCH

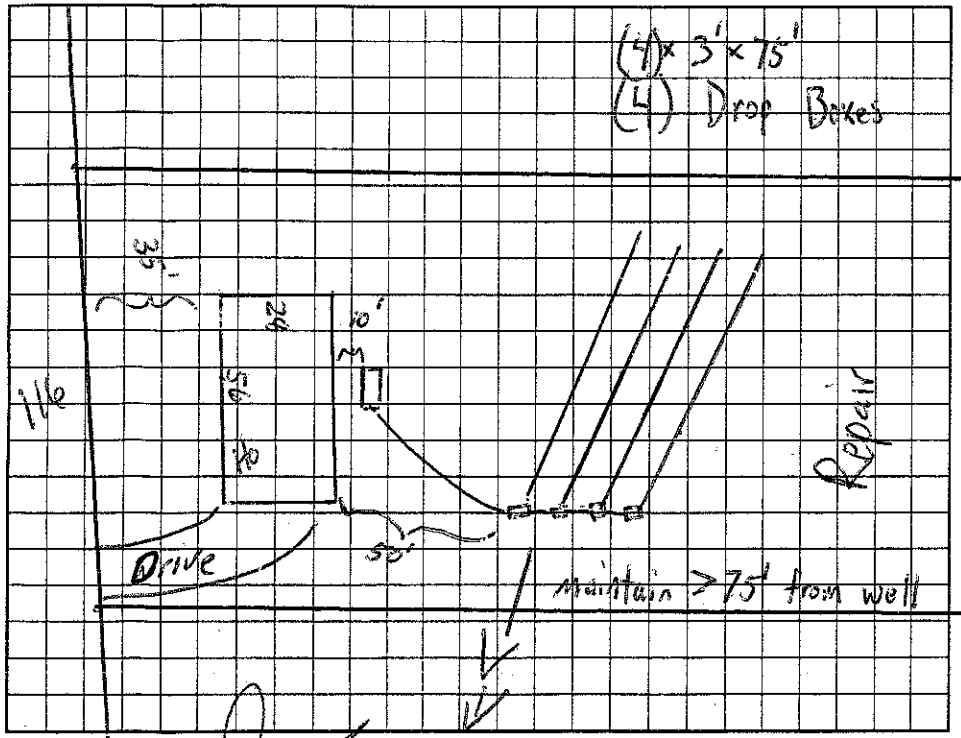

AS BUILT SKETCH

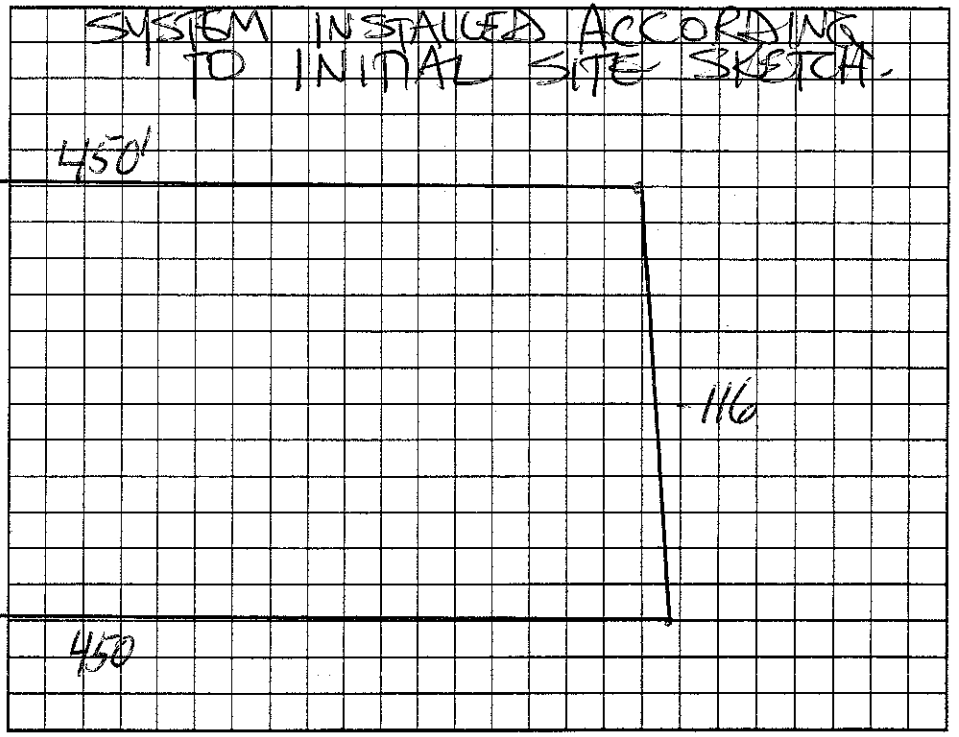

Permit can be suspended or revoked if any false information is supplied toward securing the permit/any unauthorized changes are made to the site/any unauthorized changes are made in the installation of the system. Improvement Permit with plat valid without expiration. Improvement Permit with site plan valid for sixty months. Authorization to Construct is valid for a period equal to that of Improvement Permit – not to exceed sixty months.

Signed: date 2/16/06 Installed by: SAMMY REAVIS

Improvement Permit by: date 2-14-06 Operation Permit by: STEVE HENDRICK date 9-27-06

Authorization to Construct by: date 2-14-06 Existing System Inspection by: date

HEALTH DEPT. COPY: WHITE OWNER COPY (FINAL): YELLOW OWNER COPY (INITIAL): PINK