1:00 * Replaces permit issued 5-21-05 R

IREDELL COUNTY HEALTH DEPARTMENT - ENVIRONMENTAL HEALTH ☐ STATESVILLE OFFICE 704-878-5305 ☐ MOORESVILLE OFFICE 704-664-5281

IMPROVEMENT PERMIT / AUTHORIZATION TO CONSTRUCT / OPERATION PERMIT / EXISTING SYSTEM INSPECTION

PERMIT # 163767 PIN # 4766-36-2980 DATE 27 JANUARY 2011

OWNER Gary & Linda Nichols APPLICANT: PHONE: Home/~~Cell#~~ (704) 546-7864 ~~Business#~~ (704) 437-2041

SITE ADDRESS Beechwood Farm Rd. Statesville OWNER / APPLICANT ADDRESS

SITE DIRECTIONS OLD Mocksville Rd. TR Chestnut Grove Rd. TL Beechwood Farm Rd. .2 mi on left.

SUBDIVISION Chestnut Acres BLOCK / SECTION LOT # 4 LOT AREA 2.789ac. DESIGN FLOW 360gpd. L.T.A.R. 0.3/FF/d

Septic Tank 1000 Gallons: STB 760 Date 3-24

Pump Tank Gallons: P T Date

Pump Make Model Serial #

No. Nitrification Fields: 1 No. Lines 3 Linear Feet 300

Trench Width 36" Max. Trench Bottom Depth 36" Gravel Depth NA

☑ New System ☐ Repair ☐ Expansion System Type I II (III) IV V VI

System Description: 25% Reduction System

Repair System Description: 25% Reduction - Pump

Maintenance Agreement Required ☐ YES ☒ NO

☑ GRAVITY ☐ PRESSURE

☑ Residence No. Bedrooms 3

☐ Business No. Persons 3

☐ Other No. Employees

☐ Slab ☐ Crawl Space


☐ Basement w/plumbing ☑ Basement w/o plumbing

Water Supply: ☑ Private - NEW ☐ Public ☐ Community

Comments / Conditions

Red Files

INITIAL SITE SKETCH

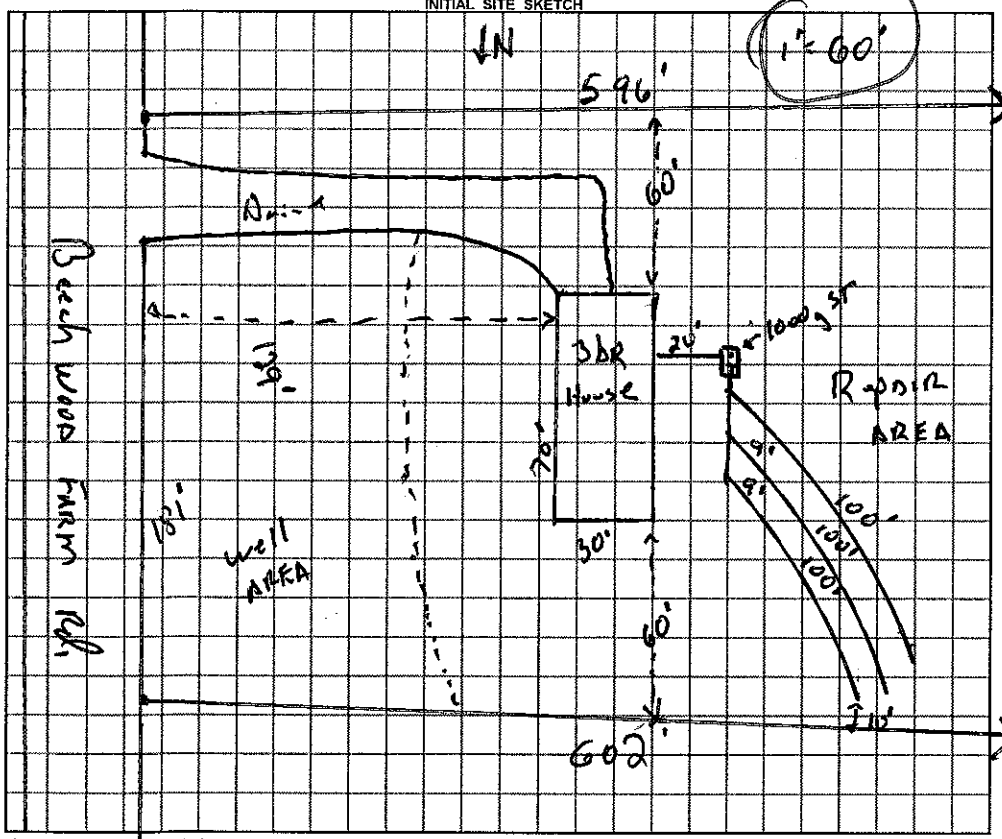

AS BUILT SKETCH

Permit can be suspended or revoked if any false information is supplied toward securing the permit / any unauthorized changes are made to the site / any unauthorized changes are made in the installation of the system.

☐ ***IMPROVEMENT PERMIT*** with plat valid without expiration. ☑ ***IMPROVEMENT PERMIT*** with plat valid ~~without expiration~~ 60 mos. ☐ ***AUTHORIZATION TO CONSTRUCT*** valid for period equal to IMPROVEMENT PERMIT--not to exceed 60 mo.

Owner / Applicant Signature: Linda Nichols Date 9-12 & 4-23-11 Installed by: Abee Grading

IMPROVEMENT PERMIT by: REHS Date 28 Jan. 11 OPERATION PERMIT by: REHS Date 7-18-17

AUTHORIZATION TO CONSTRUCT by: REHS Date Feb 9, 2012 Existing System Inspected by: REHS Date

YOU SHOULD CONTACT A LOCATOR SERVICE PRIOR TO ANY EXCAVATION

White Copy – Environmental Health YELLOW COPY (Final) Owner / Applicant PINK COPY (Initial) Owner / Applicant