IREDELL COUNTY HEALTH DEPARTMENT

STATESVILLE 704-878-5305 MOORESVILLE 704-664-5281

IMPROVEMENT PERMIT / AUTHORIZATION TO CONSTRUCT / OPERATION PERMIT / EXISTING SYSTEM INSPECTION

PERMIT# 091862 PIN# 4766369628 (pt) DATE October 5, 2000

OWNER OR CONTRACTOR JERRY JAMES PHONE: Business 872-9200 Home

ADDRESS 285 Chestnut Grove Rd. Statesville NC 28625

LOCATION Old Mocksville Road TR Chestnut Grove TL Beechwood on Right (~250')

SUBDIVISION BLOCK / SECTION LOT LOT AREA acreage SITE CLASS B DESIGN FLOW 360gpd L.T.A.R. .3

Septic Tank: 1000 Gallons; STB 1012 Date 4-5-01

Pump Tank: Gallons; PT Date

Pump Make: Model Serial No.

Nitrification Field: No Fields 1 Square Feet 1200 Linear Feet 400

No Lines 5@80' Trench Width 36" Max Trench Bottom Depth 36" Gravel Depth 12"

☒ New System ☐ Repair System Type: ☐ I ☐ II, III, IV, V, VI

System Description: Gravity conventional

Repair System Description: Gravity/pumped conventional

Maintenance Agreement Required: ☐ Yes ☒ No

☒ House/Mod. Home No. Bedrooms 3

☐ Mobile Home No. Bathrooms 1

☐ Business No. Employees

☐ Other


☐ Slab ☒ Crawl Space ☐ Basement w/plumbing ☐ Basement wo/plumbing

Water Supply: ☐ Individual ☒ Public ☐ Community

Comments/Conditions: 600'
DO NOT DRIVE OR PARK ON SEPTIC SYSTEM.
EXIT PLUMBING AT EXISTING GRADE AT LEFT REAR CORNER OF HOUSE.

Comments/Conditions: NO DATE! 28 DAYS FROM 4-5-01 IS 5-3-01. WILL CHECK OR SIGN OFF THEN.

INITIAL SITE SKETCH Not to scale

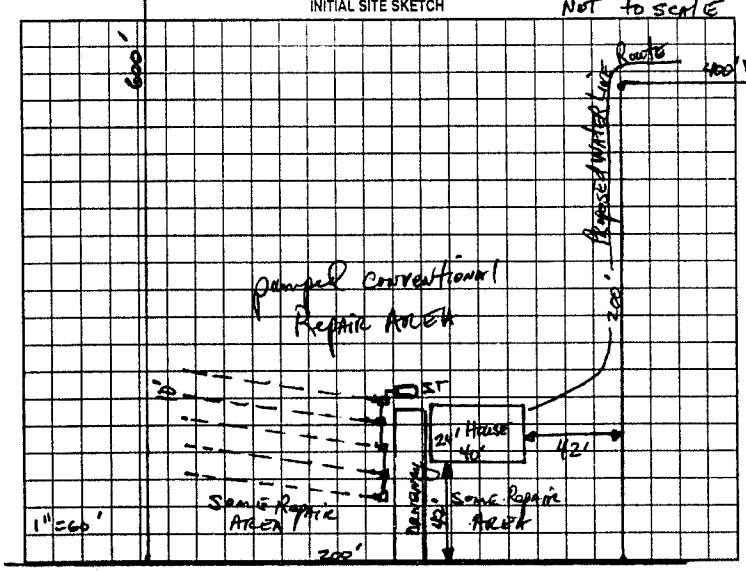

AS BUILT SKETCH

System installed as shown with poly/ok tile at risers

Permit can be suspended or revoked if any false information is supplied toward securing the permit/any unauthorized changes are made to the site/any unauthorized changes are made in the installation of the system. Improvement Permit with plat valid without expiration. Improvement Permit with site plan valid for sixty months. Authorization to Construct is valid for a period equal to that of Improvement Permit – not to exceed sixty months.

Signed: Jerry W James date 10-19-00

Improvement Permit by: [signature] date 10-5-00

Authorization to Construct by: [signature] date 10-5-00

Installed by: Steven Jordan

Operation Permit by: Jane Cook RST date 5-3-01

Existing System Inspection by: date

HEALTH DEPT. COPY: WHITE OWNER COPY (FINAL): YELLOW OWNER COPY (INITIAL): PINK