IREDELL COUNTY HEALTH DEPARTMENT

STATESVILLE 704-878-5305 MOORESVILLE 704-664-5281

IMPROVEMENT PERMIT / CERTIFICATE OF COMPLETION / OPERATION PERMIT / EXISTING SYSTEM INSPECTION

PROPERTY DESCRIPTION NO. 25722 DATE 10-14-96 TAX MAP NO. 11E-A-163 Watershed: ☐ Yes ☑ No

OWNER OR CONTRACTOR Kenneth N. James PHONE: Business _____ Home 873 9797

ADDRESS 542 Davis St. Statesville, N.C.

LOCATION Old mocksville Rd TR Chestnut Grove .8 mi left

SUBDIVISION _____ BLOCK / SECTION _____ LOT _____ LOT AREA 244X300' SITE CLASS. PS DESIGN FLOW 360 L.T.A.R. .3

Septic Tank: 1000 Gallons; STB 1012 Date 1-26-97

Pump Tank: _____ Gallons; PT _____ Date _____

Pump Make: _____ Model _____ Serial No. _____

Nitrification Field: No Fields 1 Square Feet 1200 Linear Feet 400

No Lines 4 Trench Width 36" Max Trench Bottom Depth 36" Gravel Depth 12"

☑ New System ☐ Repair System Type: I (II) III, IV, V, VI

System Description: CONV. Gravity

Repair System Description: " "

Maintenance Agreement Required: ☐ Yes ☑ No

☑ House/Mod. Home No. Bedrooms 3

☐ Mobile Home No. Bathrooms 2 1/2

☐ Business No. Employees _____


☐ Other _____

☐ Slab ☑ Crawl Space ☐ Basement w/plumbing ☐ Basement wo/plumbing

Water Supply: ☐ Individual ☐ Community ☑ Public

Comments:


INITIAL SITE SKETCH

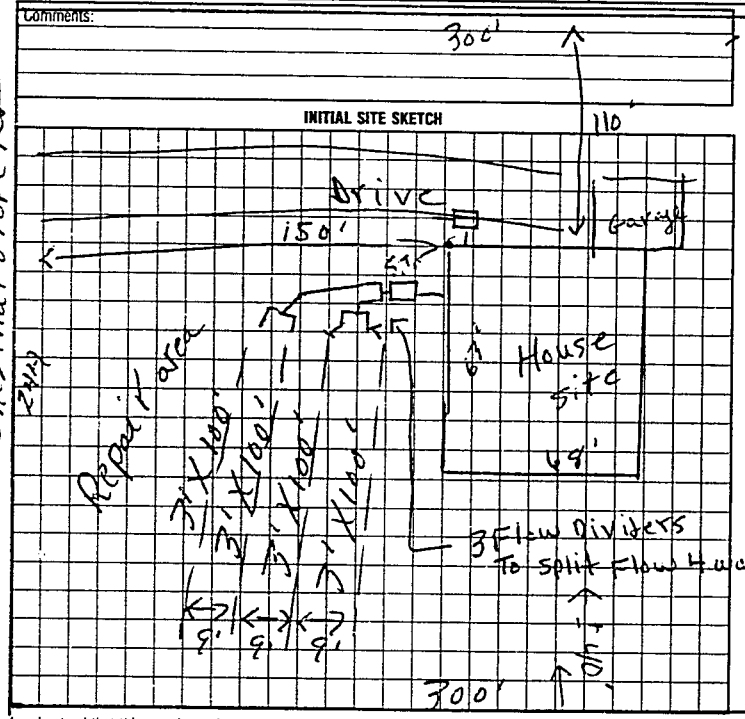

Comments:

* House shifted
Tank set on side of House
~15ft

AS BUILT SKETCH

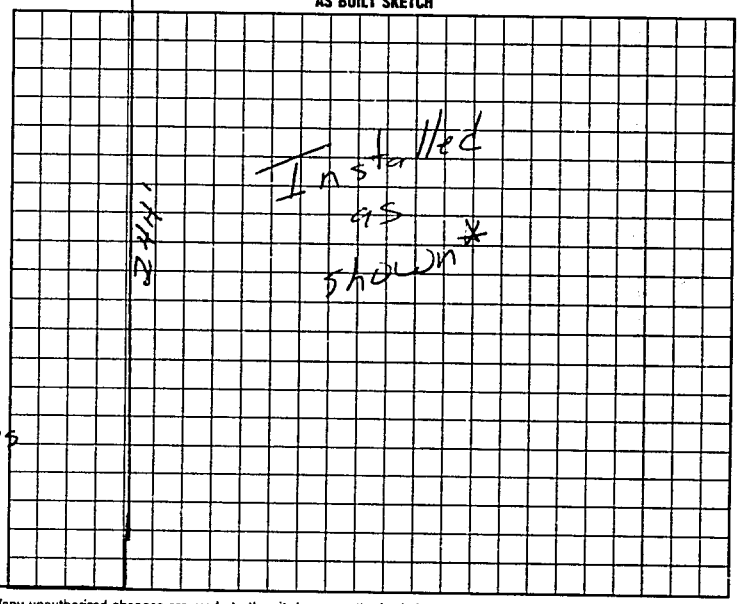

I understand that this permit can be suspended or revoked if any false information is supplied toward securing the permit/any unauthorized changes are made to the site/any unauthorized changes are made in the installation of the system.

Signed: X Kenneth N. James

Improvement Permit by: L.C. Moore date 10-14-96

Existing system inspection by: L.C. Moore date 10-14-96

Installed by: David Yountz

Certificate of Completion by: _____ date _____

Operation Permit by: M.A. CATES date 4-9-97

authorization to construct

HEALTH DEPT. COPY. WHITE INSPECTION COPY (FINAL). GREEN OWNER COPY (FINAL). YELLOW INSPECTION COPY (INITIAL). PINK OWNER COPY (INITIAL). GOLD

authorization TO Const EXPIRES Comes from issue

18100