IREDELL COUNTY HEALTH DEPARTMENT

Statesville Office (704) 878-5305 Mooresville Office (704) 660-3625 PERMIT # 181204

IMPROVEMENT PERMIT / AUTHORIZATION TO CONSTRUCT / OPERATION PERMIT / EXISTING SYSTEM

PIN # 4766516472

APPLICANT: Kenneth Robertson APPLICANT ADDRESS: Po Box 4382

SITE ADDRESS: 673 River Hill Rd. PHONE: 704-488-4569 ALT. PHONE: N/A

SITE DIRECTIONS: Hwy 64E TL River Hill Rd. TL 1st Drive after crossing over I-40

SUBDIVISION: N/A SECTION: N/A LOT # N/A LOT AREA: 82.78 acres DESIGN FLOW: 600 gpd L.T.A.R.: 0.3

Septic Tank 1500 (gal) STB 338-1500 Date 9-9-14
Pump Tank (gal) PT Date
Pump Make Model Serial #
Nitrification Fields 1 # Lines 5 Linear Ft: 500
Trench Width 36" Max. Trench Bottom Depth 32" Gravel Depth N/A


☑ New System ☐ Repair ☐ Expansion System Type: I II III IV V VI
System Description: 25% Reduction
Repair System Description: 25% Reduction
Maintenance Agreement Required: ☐ YES ☑ NO
☐ GRAVITY ☐ PRESSURE

☑ Residence No. Bedrooms 5
☐ Business No. Persons
☐ Other No. Employees
☑ Slab ☐ Crawl Space
☐ Basement w/plumbing ☐ Basement w/o plumbing

Water Supply: ☑ Private ☐ Public ☐ Community

Comments / Conditions: Install a 25% Reduction system on contour with serial distribution. Install with trench bottom no deeper than 32" on high side. Well area is 100' from all components of septic tank system.

INITIAL SITE SKETCH

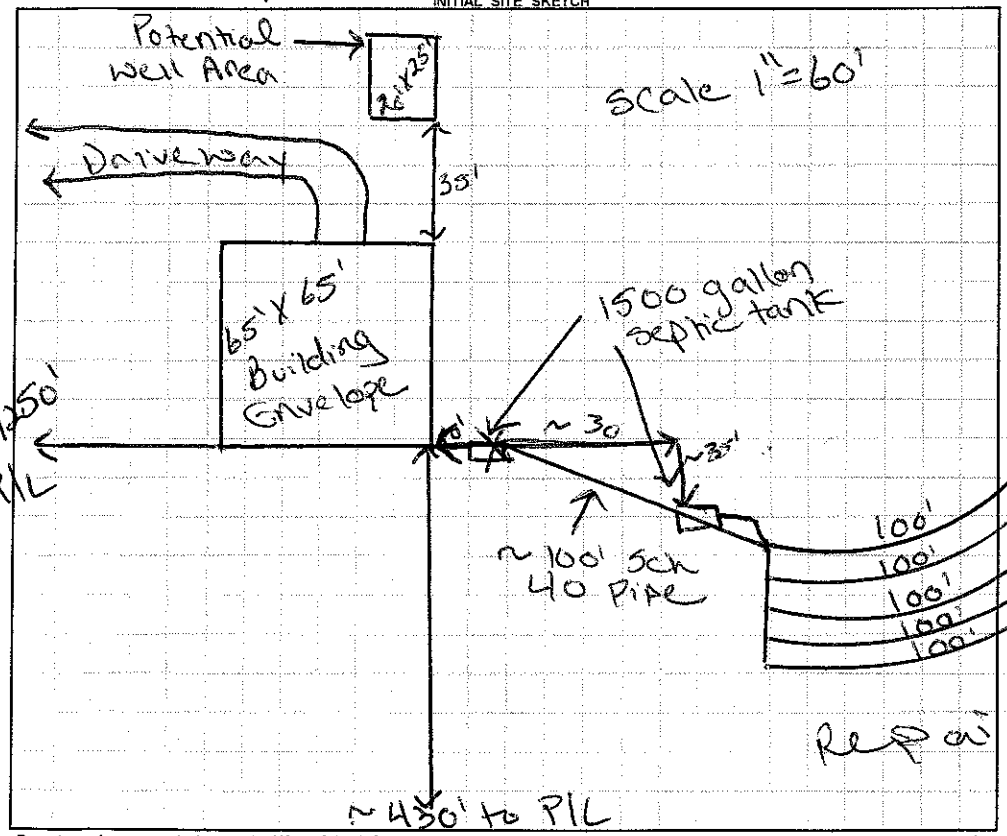

AS BUILT SKETCH

- Red Poly 10K filter installed
- Quick 4 Chamber installed
- Installed as drawn

Permit can be suspended or revoked if any false information is supplied toward securing the permit / any unauthorized changes are made to the site / any unauthorized changes are made in the installation of the system. **CONTACT A LOCATOR SERVICE PRIOR TO ANY EXCAVATION**

☐ **IMPROVEMENT PERMIT** *with plat valid without expiration.* ☑ **IMPROVEMENT PERMIT** *with site plan valid for 60 mos.* ☑ **AUTHORIZATION TO CONSTRUCT** *valid for period equal to IMPROVEMENT PERMIT--not to exceed 60 mo.*

Owner / Applicant Signature: By: Susan Blumenstein Date: 10-8-13 Installed by: Richard Abernathy

IMPROVEMENT PERMIT by: Justin Henderson Date: 10-7-13 OPERATION PERMIT by: Justin Henderson Date: 10-10-14

AUTHORIZATION TO CONSTRUCT by: Justin Henderson Date: 10-7-13 Existing System Inspected by: Date:

Health Dept. Copy - WHITE Applicant (Final Approval) - YELLOW Applicant (Conditional Approval) - PINK