IREDELL COUNTY HEALTH DEPARTMENT

Statesville Office (704) 878-5305 Mooresville Office (704) 660-3625 PERMIT # 202108 DRK

IMPROVEMENT PERMIT / AUTHORIZATION TO CONSTRUCT / OPERATION PERMIT / EXISTING SYSTEM

PIN # 4766565332

APPLICANT: Andrew Erving APPLICANT ADDRESS: 360 Chestnut Grove Rd Statesville NC 28625

SITE ADDRESS: 360 Chestnut Grove Rd Statesville NC 28625 PHONE: 231-883-5910 ALT. PHONE: N/A

SITE DIRECTIONS: I 40 E Ext 154 T/L old Mocksville T/R Chestnut Grove Rd

SUBDIVISION: Gebrial Acres SECTION: N/A LOT # 6 LOT AREA: 2ac DESIGN FLOW: EX L.T.A.R.: EX


Septic Tank	EX (gal)	STB	EX	Date	EX	☐ New System ☐ Repair ☐ Expansion	System Type: I (II) III IV V VI	☒ Residence	No. Bedrooms 4
Pump Tank	N/A (gal)	PT	N/A	Date	N/A	System Description:	EX	☐ Business	No. Persons
Pump Make	EX	Model	EX	Serial #	EX	Repair System Description:	EX	☐ Other	No. Employees
# Nitrification Fields	1	# Lines	EX	Linear Ft:		Maintenance Agreement Required:	☐ YES ☒ NO	☐ Slab	☒ Crawl Space
Trench Width	EX	Max. Trench Bottom Depth	EX	Gravel Depth	EX	☒ GRAVITY	☐ PRESSURE	☐ Basement w/plumbing	☐ Basement w/o plumbing

Water Supply: ☐ Private ☒ Public ☐ Community


Comments / Conditions:

Any building foundation must be ≥5' from any part of STS.

INITIAL SITE SKETCH

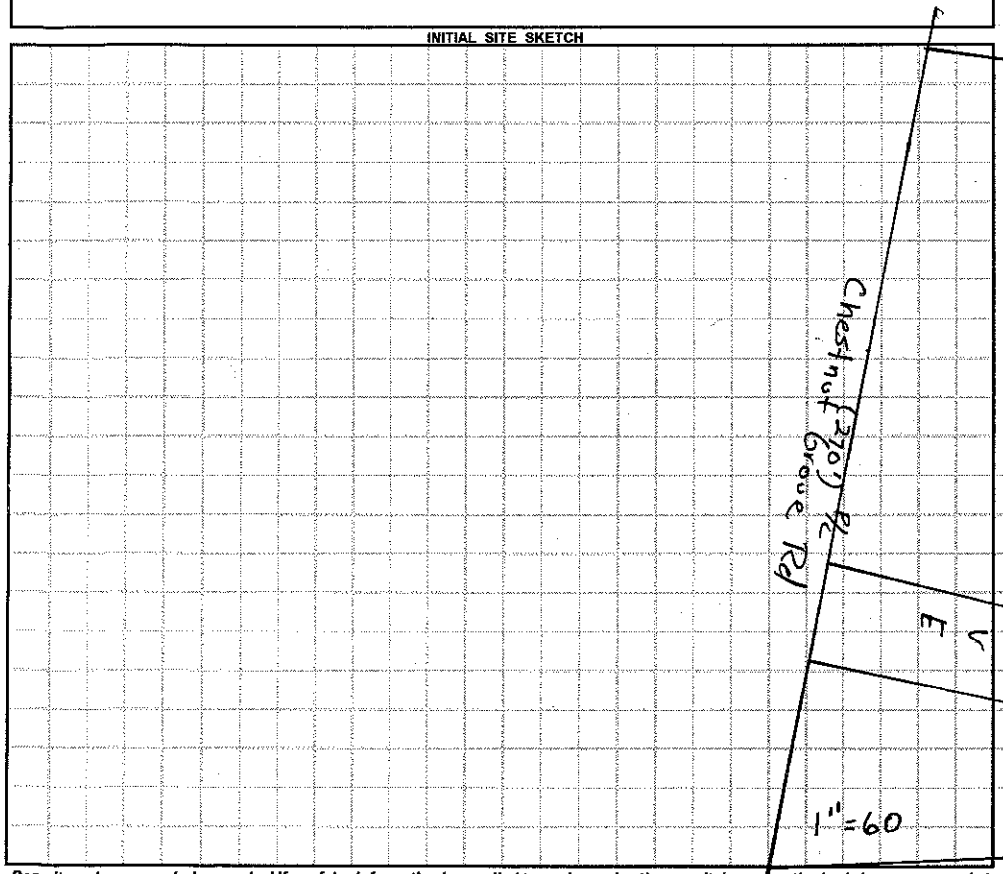

AS BUILT SKETCH

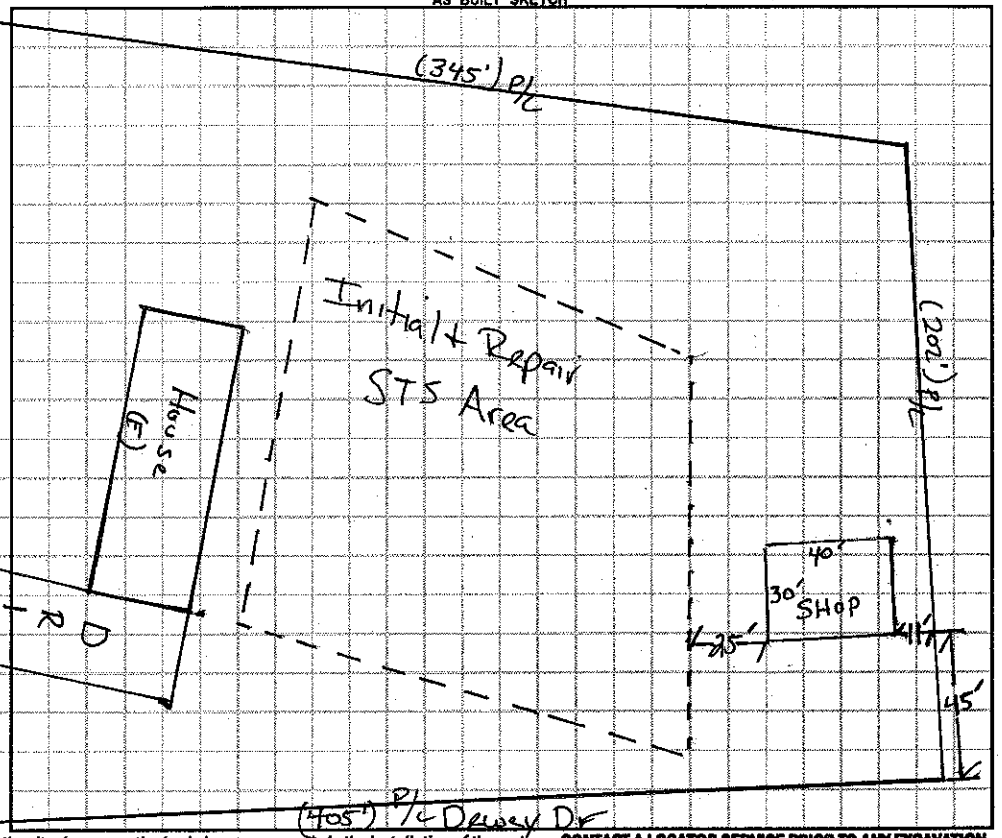

Permit can be suspended or revoked if any false information is supplied toward securing the permit / any unauthorized changes are made to the site / any unauthorized changes are made in the installation of the system. **CONTACT A LOCATOR SERVICE PRIOR TO ANY EXCAVATION**

☐ **IMPROVEMENT PERMIT** *with plat valid without expiration.* ☐ **IMPROVEMENT PERMIT** *with site plan valid for 60 mos.* ☐ **AUTHORIZATION TO CONSTRUCT** *valid for period equal to IMPROVEMENT PERMIT--not to exceed 60 mo.*

Owner / Applicant Signature: Andrew Erving Date: Installed by:

IMPROVEMENT PERMIT by: Date: OPERATION PERMIT by: Date:

AUTHORIZATION TO CONSTRUCT by: Date: Existing System Inspected by: Date: 03/20/14

Health Dept. Copy - WHITE Applicant (Final Approval) - YELLOW Applicant (Conditional Approval) - PINK