IREDELL COUNTY HEALTH DEPARTMENT

STATESVILLE 704-878-5305 — MOORESVILLE 704-664-5281

IMPROVEMENT PERMIT / AUTHORIZATION TO CONSTRUCT / OPERATION PERMIT / EXISTING SYSTEM INSPECTION

This permit void previously issued permit #094792 + #094794 dated 4/3/01. CI

PERMIT# 114551 20 PIN# 4766-56-~~5330~~ 5332 DATE 8/5/03

OWNER OR CONTRACTOR Aaron Sadowski ~~328 Simon Rd~~ PHONE: Business (704) 902-1836 Home (704) 873-0906

ADDRESS 328 Simon Rd Statesville NC 28625

LOCATION 64 E @ River Hill Rd @ Chestnut Grove on Left before Deer Drive

SUBDIVISION Gabriel Acres BLOCK / SECTION — LOT 12 LOT AREA 2.10 Acres SITE CLASS. PF DESIGN FLOW 480 L.T.A.R. .30

Septic Tank: 1000 Gallons; STB 1012 Date 1-13-03

Pump Tank: ____ Gallons; PT ____ Date ____

Pump Make: ____ Model ____ Serial No. ____

Nitrification Field: No Fields 1 Square Feet 1800 Linear Feet 534

No Lines 4@134' Trench Width 36" Max Trench Bottom Depth 32" Gravel Depth 12"

☒ New System ☐ Repair System Type: I (II) III, IV, V, VI

System Description: Gravity Conv.

Repair System Description: Gravity 25% Red.

Maintenance Agreement Required: ☐ Yes ☒ No

☒ House/Mod. Home ☐ Mobile Home ☐ Business ☐ Other


No. Bedrooms 4 No. Bathrooms 2 No. Employees ____

Water Supply: ☐ Individual ☒ Public ☐ Community

☐ Slab ☒ Crawl Space ☐ Basement w/plumbing ☐ Basement wo/plumbing



INITIAL SITE SKETCH

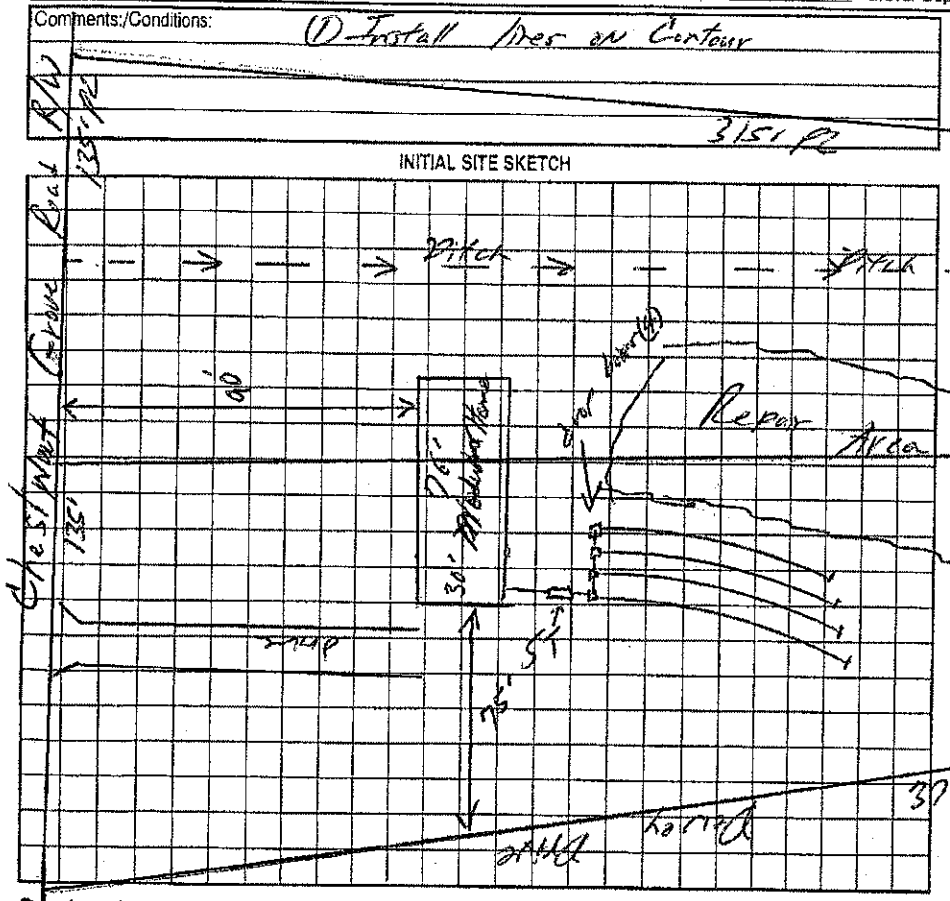

Comments/Conditions: Ref-Tite Filter + ST Marker Installed

AS BUILT SKETCH

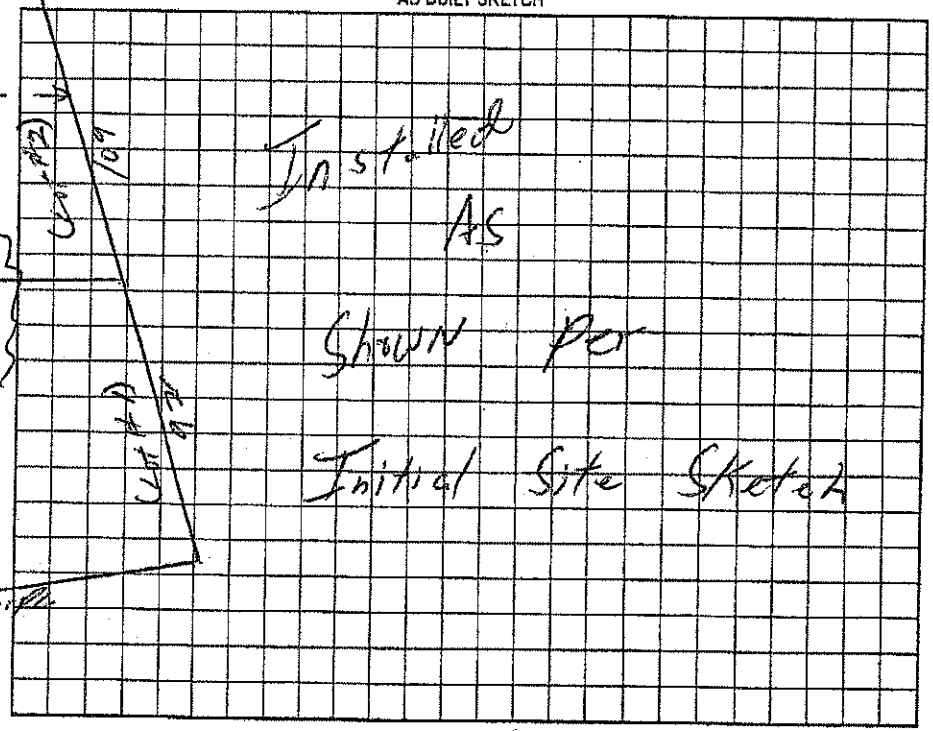

Permit can be suspended or revoked if any false information is supplied toward securing the permit/any unauthorized changes are made to the site/any unauthorized changes are made in the installation of the system. Improvement Permit with plat valid without expiration. Improvement Permit with site plan valid for sixty months. Authorization to Construct is valid for a period equal to that of Improvement Permit – not to exceed sixty months.

Signed: Gerald Smith date ____

Improvement Permit by: William O. Johnson date 8/5/03

Authorization to Construct by: William O. Johnson date 8/5/03

Installed by: A-1 Backhoe

Operation Permit by: William O. Johnson date 8-9-03

Existing System Inspection by: ____ date ____

HEALTH DEPT. COPY: WHITE OWNER COPY (FINAL): YELLOW OWNER COPY (INITIAL): PINK