IREDELL COUNTY HEALTH DEPARTMENT

THIS PERMIT REPLACES EXPIRED PERMIT # 107866 (1)

STATESVILLE 704-878-5305 MOORESVILLE 704-664-5281

IMPROVEMENT PERMIT / AUTHORIZATION TO CONSTRUCT / OPERATION PERMIT / EXISTING SYSTEM INSPECTION

PERMIT# 118270 PIN# 4766-56-8252 DATE 2-16-04

OWNER OR CONTRACTOR ALFI GEBRAIL PHONE: Business 704-892-6731 Home 704-892-1186

ADDRESS P.O. Box 1381, CORNELIUS, NC 28031

LOCATION OLD MOCKSVILLE ROAD NE, TR CHESTNUT GROVE ROAD, 1.1 MILES ON RIGHT ACROSS FROM WOOTEN FARM

SUBDIVISION GEBRAIL ACRES BLOCK / SECTION ____ LOT 4 LOT AREA 0.699 ACRE SITE CLASS. PS DESIGN FLOW 360 L.T.A.R. 0.30 GPD/FT² ROAD,

Septic Tank: 1000 Gallons; STB 1007 Date 1-26-04
Pump Tank: ____ Gallons; PT ____ Date ____
Pump Make: ____ Model ____ Serial No. ____
Nitrification Field: No Fields 1 Square Feet 1200 Linear Feet 400
No Lines FOUR Trench Width 36" Max Trench Bottom Depth 36" Gravel Depth 12"

☒ New System ☐ Repair System Type: I, (II), III, IV, V, VI
System Description: CONVENTIONAL, GRAVITY
Repair System Description: 25% REDUCTION, PUMP
Maintenance Agreement Required: ☐ Yes ☒ No

☐ House/Mod. Home No. Bedrooms 3
☒ Mobile Home No. Bathrooms 2
☐ Business No. Employees ____
☐ Other ____


☐ Slab ☒ Crawl Space ☐ Basement w/plumbing ☐ Basement wo/plumbing

Water Supply: ☐ Individual ☒ Public ☐ Community

Comments:/Conditions: INSTALL SYSTEM ON CONTOUR AS FLAGGED ON SITE

Comments:/Conditions: SEPTIC TANK WITH MARKER INSTALLED USING "TUFTITE" FILTER

INITIAL SITE SKETCH

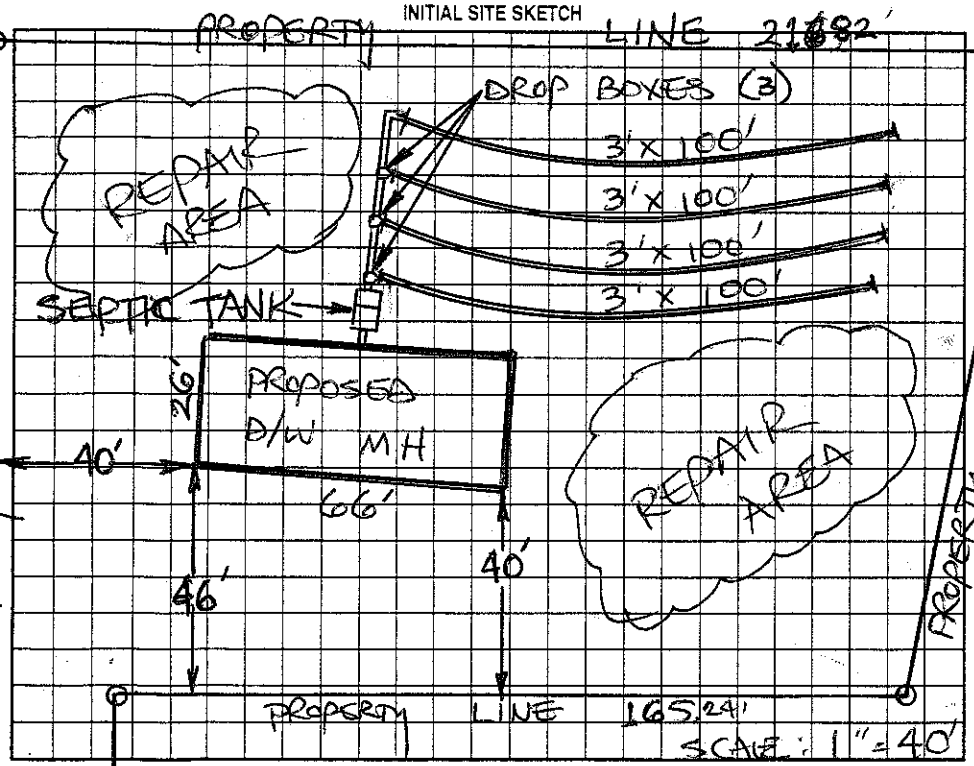

AS BUILT SKETCH

SYSTEM INSTALLED ACCORDING TO INITIAL SITE SKETCH

Permit can be suspended or revoked if any false information is supplied toward securing the permit/any unauthorized changes are made to the site/any unauthorized changes are made in the installation of the system. Improvement Permit with plat valid without expiration. Improvement Permit with site plan valid for sixty months. Authorization to Construct is valid for a period equal to that of Improvement Permit – not to exceed sixty months.

Signed: Ken Wilkins date 2-17-04 Installed by: A&S GRADING

Improvement Permit by: STEVE HEDRICK date 2-16-04 Operation Permit by: STEVE HEDRICK date 3-25-04

Authorization to Construct by: STEVE HEDRICK date 2-16-04 Existing System Inspection by: ____ date ____

HEALTH DEPT. COPY: WHITE OWNER COPY (FINAL): YELLOW OWNER COPY (INITIAL): PINK